

MISSISSIPPI
BOARD OF WATER COMMISSIONERS
416 North State Street
Jackson, Mississippi 39201

CODED

WATER WELL DRILLERS LOG

Carroll
E 48
7-68

7-5-68 19 BUTANE GAS CO. OF G. WOOD CARROLL
date well completed firm name county well located

LANDOWNER:
R. N. HAMMONS, JR.
Greenwood, Miss.
(mailing address)

WELL LOCATION:
sec. 23 T. 19 N R. 3 E
3 miles W of CARROLLTON
(distance) (direction) (nearest town)

description of formations encountered	from to	
<u>Clay</u>	<u>0</u>	<u>63</u>
<u>SAND + Clay</u>	<u>63</u>	<u>174</u>
<u>SAND</u>	<u>174</u>	<u>196</u>
<u>SAND + Clay</u>	<u>196</u>	<u>214</u>

WELL PURPOSE:
(home, irrigation, municipal, industrial)

WELL COMPLETION DATA:

(1) diameter (inches) 4 3/4

(2) total depth (feet) 187

(3) static water level (feet) 146 below above top of ground.

(4) casing Steel, 177
(material) (depth)
4" if telescope see back.
(size)


(5) screen 10', 177
(length) (depth to top)
2", Stainless Steel
(size) (material)

(6) pump 3/4, 8
(HP) (yield gpm)
Elec.
(type power)

(7) electric log no
(yes or no)
(organization running log)

(8) how well bottom plugged
BACK PRESSURE VALVE

CODED

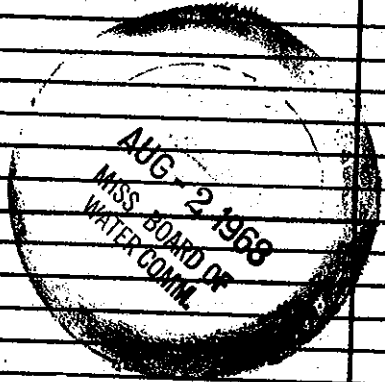

DRILLERS REMARKS: