

CODED

MISSISSIPPI
BOARD OF WATER COMMISSIONERS
416 North State Street
Jackson, Mississippi 39201

WATER WELL DRILLERS LOG

Carroll
E49
8-68

Aug 8 19 68 Jack Martin Carroll
date well completed firm name county well located

LANDOWNER:

W. D. Mann

description of formations encountered

Clay

from to

0 26

Carrollton Rt 2
(mailing address)

pipe clay

26 34

WELL LOCATION:

sec. 35 T 19 N R 3 E
3 miles SW of Carrollton
(distance) (direction) (nearest town)

sand

34 41

sand & gravel

41 48

sand

48 96


WELL PURPOSE:

Home
(home, irrigation, municipal, industrial)

WELL COMPLETION DATA:

- (1) diameter (inches) 2
- (2) total depth (feet) 96
- (3) static water level (feet) 24 below above top of ground.
- (4) casing Steel, 91, (material) (depth)
2 (size) If telescope see back.
- (5) screen 5, 91 (length) (depth to top)
2, Stainless Steel (size) (material)
- (6) pump 1, 10 (HP) (yield gpm)
Elec (type power)
- (7) electric log no (yes or no)
(organization running log)
- (8) how well bottom plugged Cap

CODED

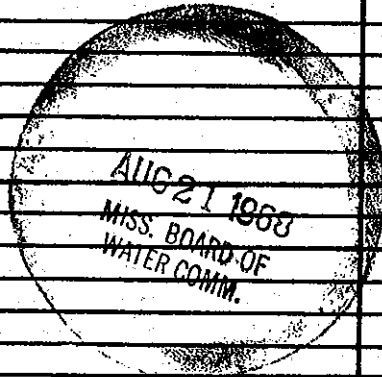

DRILLERS REMARKS: