

CARROLL

E 51

3-17-62

MISSISSIPPI BOARD OF WATER COMMISSIONERS

CODED

F

WATER WELL DRILLERS LOG

Date: MAR 17, 1962, Driller: DELTA DRILLING Co. County CARROLL

(Name)

(1) Owner of Land: <u>DW. FELTS</u> (Name)	Description & Color of Materials Sand, Clay, Red Clay, Shell, etc.	Thick- ness Feet	Depth Feet
<u>RTE. 3, CARROLLTON, MISS.</u> (Address)	<u>RED CLAY</u>	<u>32</u>	<u>32</u>
(2) Location: <u>NW 1/4, SW 1/4, Sec. 32 T9N R3E</u>	<u>RED SAND</u>	<u>20</u>	<u>52</u>
_____ miles _____ of _____	<u>GRAVEL</u>	<u>42</u>	<u>94</u>
(distance) (direction) (Nearest Town)	<u>SAND</u>	<u>12</u>	<u>106</u>
(3) Topography: <u>HILLY</u>	<u>GRAVEL</u>	<u>6</u>	<u>112</u>
(Hilly) (Flat) (Level)	<u>SAND</u>	<u>98</u>	<u>200</u>
(4) Purpose of Well: <u>DOMESTIC</u> (Domestic Irrigation Municipal, Industrial, Other)			

CODED


Information upon completion of well:

- (1) Diameter 2 inches.
- (2) Total Depth 200 feet.
- (3) Water Level 134 feet below top of ground.
- (4) Cased to 200, Size 2
- (5) Screen: Size 2, Length 10
- (6) Were any formations sealed against pollution?  
\_\_\_\_\_ yes,  no.

If YES depth of formation \_\_\_\_\_

Why \_\_\_\_\_

Drillers Remarks: \_\_\_\_\_

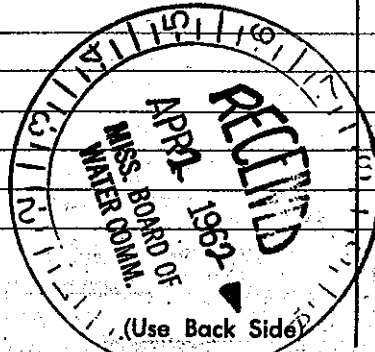

Well No.

Mail this copy to Board of Water Commissioners 429 Miss. St. Jackson, Miss