

CARROLL MISSISSIPPI BOARD OF WATER COMMISSIONERS

E 40 60  
9-64

WATER WELL DRILLERS LOG

CODED

Date: Sept, 1964, Driller: Jack Martin County Holmes  
(Name)

(1) Owner of Land: <u>J.C. Staten</u> (Name)	Description & Color of Materials Sand, Clay, Red Clay, Shell, etc.	Thick- ness Feet	Depth Feet
<u>Carrollton</u> (Address)	<u>Clay</u>	<u>21</u>	<u>21</u>
(2) Location: <u>SW 1/4, SW 1/4, Sec. 15 T19R3E</u>	<u>Sand</u>	<u>40</u>	<u>61</u>
<u>3</u> miles <u>W</u> of <u>Carrollton</u> (distance) (direction) (Nearest Town)	<u>Sand - Gravel</u>	<u>7</u>	<u>68</u>
(3) Topography: <u>Hilly</u> (Hilly) (Flat) (Level)	<u>Sand</u>	<u>62</u>	<u>130</u>
(4) Purpose of Well: <u>Domestic</u> (Domestic Irrigation Municipal, Industrial, Other)			

Information upon completion of well:


- (1) Diameter 2 inches.
- (2) Total Depth 130 feet.
- (3) Water Level 99 feet below top of ground.
- (4) Cased to 125, Size 2
- (5) Screen: Size 2, Length 4
- (6) Were any formations sealed against pollution?  
\_\_\_\_\_ yes, \_\_\_\_\_ no.

If YES depth of formation \_\_\_\_\_

Why \_\_\_\_\_

Drillers Remarks: \_\_\_\_\_

CODED

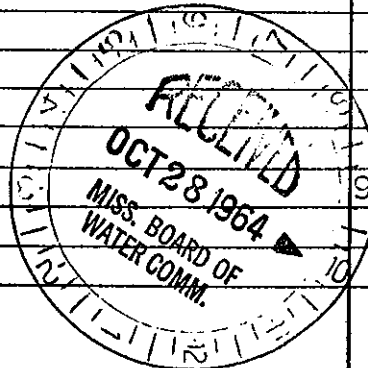

(Use Back Side)

Well No.

Mail this copy to Board of Water Commissioners 429 Miss. St. Jackson, Miss