

CARROLL MISSISSIPPI BOARD OF WATER COMMISSIONERS

F 19
4-61

WATER WELL DRILLERS LOG *Code C*

Date: *April*, 19*61*, Driller: *Robert E. Roney* County *Carroll*
(Name)


(1) Owner of Land: <i>North Carrollton</i> (Name)	Description & Color of Materials Sand, Clay, Red Clay, Shell, etc.	Thick- ness Feet	Depth Feet
<i>North Carrollton, Miss.</i> (Address)	<i>Top Soil</i>		<i>0-24</i>
(2) Location: $\frac{1}{4}$, $\frac{1}{4}$, Sec. <i>7</i> T. <i>19</i> R. <i>4</i>	<i>Red Sand</i>		<i>24-60</i>
_____ miles _____ of <i>City</i> (distance) (direction) (Nearest Town)	<i>Shale</i>		<i>60-84</i>
(3) Topography: <input checked="" type="checkbox"/> (Hilly) <input type="checkbox"/> (Flat) <input type="checkbox"/> (Level)	<i>White Sand with Mud</i>		<i>84-160</i>
(4) Purpose of Well: <i>Municipal</i> (Domestic Irrigation Municipal, Industrial, Other)	<i>Sandy Shale</i>		<i>160-254</i>
	<i>Broken Sand</i>		<i>254-290</i>
	<i>Lumber</i>		<i>290-340</i>
	<i>Green Sand</i>		<i>340-360</i>
	<i>Hard Shale</i>		<i>360-400</i>
	<i>White Sand</i>		<i>400-464</i>

Information upon completion of well:

- (1) Diameter *10"* inches.
- (2) Total Depth *460'* feet.
- (3) Water Level *2* feet below top of ground.
- (4) Cased to *400'*, Size *10"*
- (5) Screen: Size *60'*, Length *40'*
- (6) Were any formations sealed against pollution?
 yes, _____ no.

If YES depth of formation *10" casing*
was cemented in place
Why _____

Drillers Remarks: _____

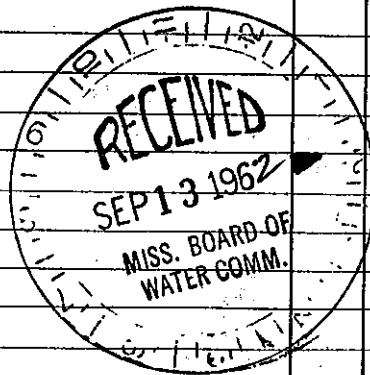

Well No.

(Use Back Side)

Put this copy for your office files.