

CARROLL

MISSISSIPPI BOARD OF WATER COMMISSIONERS

F 21

WATER WELL DRILLERS LOG

CODED

1-7-63

Date: JAN 7, 1963, Driller: DELTA DRILLING Co. County CARROLL

(Name)

(1) Owner of Land: W. D. LONG
(Name)

RTE, 2, BOX 38, MC-CARLEY, MISS
(Address)

(2) Location: 1/4, 1/4, Sec. 28 T 19 R 4

miles of
(distance) (direction) (Nearest Town)

(3) Topography:
(Hilly) (Flat) (Level)

(4) Purpose of Well:
(Domestic Irrigation
Municipal, Industrial, Other)

Description & Color of Materials
Sand, Clay, Red Clay, Shell, etc.

Thick-
ness
Feet

Depth
Feet

CLAY	65	65
SAND	73	138
CLAY	11	149
SHALE	21	170
GREEN SAND	41	211
SHALE	22	233
SAND	41	274

Information upon completion of well:

(1) Diameter 2 inches.

(2) Total Depth 190 feet.

(3) Water Level _____ feet below top of ground.

(4) Cased to 165, Size 2"

(5) Screen: Size 2", Length 25'
PERFORATED PIPE

(6) Were any formations sealed against pollution?

yes, no.


If YES depth of formation _____

Why _____

Drillers Remarks: WELL SET 190'

HOLE DRILLED 274'

CODED

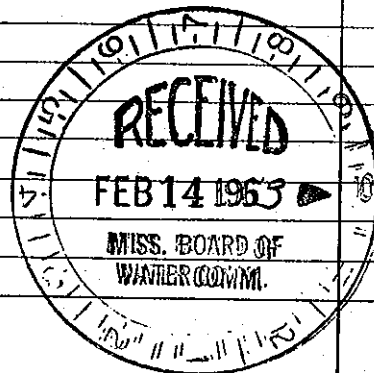

(Use Back Side)

Well No.

Mail this copy to Board of Water Commissioners 429 Miss. St. Jackson, Miss.