

Carroll  
722  
11-67

MISSISSIPPI  
BOARD OF WATER COMMISSIONERS  
416 North State Street  
Jackson, Mississippi 39201

Code  
Carroll

WATER WELL DRILLERS LOG

Nov. 1967 date well completed  
Robert E. Kately Co. firm name  
~~Carroll~~ county well located

LANDOWNER: McCarley  
Water Assn. Inc.  
McCarley Miss.  
(mailing address)

description of formations encountered	from	to
Clay	0	18
Sand	18	39
Shale	39	61
Rock	61	62
Shale	62	86
Sand	86	125
Shale	125	135
Sand	135	145
Shale & Sand	145	265
Sand	265	274
Shale	274	386
Sand	386	422
Shale	422	424

WELL LOCATION: no map right in McCarley  
12 sec. T 9 N R 7 E AE  
3 miles East of Carrollton  
(distance) (direction) (nearest town)

WELL PURPOSE:  
(home, irrigation, municipal, industrial)

WELL COMPLETION DATA:

(1) diameter (inches) 8x4

(2) total depth (feet) 424

(3) static water level (feet) 138 below top of ground


(4) casing Bl. 386 (material) (depth)  
8" (size) If telescope see back.

(5) screen 40 386 (length) (depth to top)  
4" (size) S.S. (material)

(6) pump 10 100 (HP) (yield gpm)  
Electric (type power)

(7) electric log No (yes or no)  
(organization running log)

(8) how well bottom plugged BPU

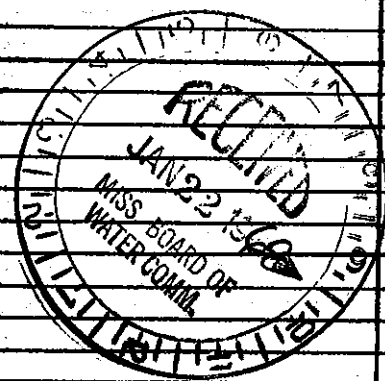

DRILLERS REMARKS: