


CARROLL MISSISSIPPI BOARD OF WATER COMMISSIONERS

F 47
11-12-62

WATER WELL DRILLERS LOG CODED

Date: NOV. 12, 1962, Driller: DELTA DRILLING Co. County CARROLL
(Name)

	Description & Color of Materials Sand, Clay, Red Clay, Shell, etc.	Thick- ness Feet	Depth Feet
(1) Owner of Land: <u>JAMES NEILL</u> (Name)	<u>CLAY</u>	<u>40</u>	<u>40</u>
<u>CARROLLTON MISS.</u> (Address)	<u>GUMBO</u>	<u>24</u>	<u>64</u>
(2) Location: <u>SE 1/4, NE 1/4, Sec. 9 TANGLE</u>	<u>GREEN SAND w/ 6" ROCK</u>	<u>16</u>	<u>80</u>
_____ miles _____ of _____ (distance) (direction) (Nearest Town)	<u>SHALE w/ ROCK</u>	<u>10</u>	<u>90</u>
(3) Topography: _____ (Hilly) (Flat) (Level)	<u>GREEN SAND</u>	<u>60</u>	<u>150</u>
(4) Purpose of Well: <u>DOMESTIC</u> (Domestic Irrigation Municipal, Industrial, Other)	<u>SHALE</u>	<u>21</u>	<u>171</u>
Information upon completion of well:			
(1) Diameter <u>2</u> inches.	CODED		
(2) Total Depth <u>150</u> feet.	CODED		
(3) Water Level <u>80</u> feet below top of ground.	CODED		
(4) Cased to <u>125</u> , Size <u>2"</u>	CODED		
(5) Screen: Size <u>2"</u> , Length <u>25'</u> <u>PERFORATED PIPE</u>	CODED		
(6) Were any formations sealed against pollution? _____ yes, _____ no.			
If YES depth of formation _____			
Why _____			
Drillers Remarks: <u>1/2 H.P. "MONITOR"</u> <u>RED JACKET PUMP SET 100'</u> <u>IN WELL W 1-1/8" WOOD ROD</u>			

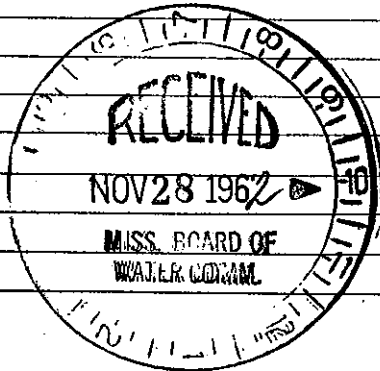

Well No.

(Use Back Side)

Mail this copy to Board of Water Commissioners 429 Miss. St. Jackson, Miss.