


CARROLL MISSISSIPPI BOARD OF WATER COMMISSIONERS

F49  
12-63

**CODED**  
**WATER WELL DRILLERS LOG**

Date: Dec, 1963, Driller: Jack Martin County Halbert  
(Name)

(1) Owner of Land: <u>J. L. Spencer</u> (Name)	Description & Color of Materials Sand, Clay, Red Clay, Shell, etc.	Thick- ness Feet	Depth Feet
<u>Carrollton Miss</u> (Address)	Top clay	12	12
(2) Location: <u>NW 1/4, NW 1/4, Sec. 30 T19R5E</u>	Pipe clay	23	35
<u>5</u> miles <u>West</u> of <u>Winona</u> (distance) (direction) (Nearest Town)	Black mud	46	81
(3) Topography: <u>Hilly</u> (Hilly) (Flat) (Level)	Green shale & sand	7	88
(4) Purpose of Well: <u>Domestic</u> (Domestic Irrigation Municipal, Industrial, Other)	Rocks & shale	3	91
Information upon completion of well:	Sand	5	96
(1) Diameter <u>2</u> inches.	Sandy - shale	4	100
(2) Total Depth <u>236</u> feet.	Sand	5	105
(3) Water Level <u>67</u> feet below top of ground.	Mud	51	126
(4) Cased to <u>226</u> , Size <u>2</u>	Sand (Coarse)	14	140
(5) Screen: Size <u>2</u> , Length <u>10</u>	v (med fine)	10	150
(6) Were any formations sealed against pollution? yes _____ no _____	Rock	1	151
If YES depth of formation _____	Mud	3	154
Why _____	Fine sand & shale		168
Drillers Remarks: <u>CODED</u>	Rock	6"	168
	Mud	30	198
	Mud & sand	25	223
	Sand	17	240
	Scattered Thin rock layers		
	from 88-105		

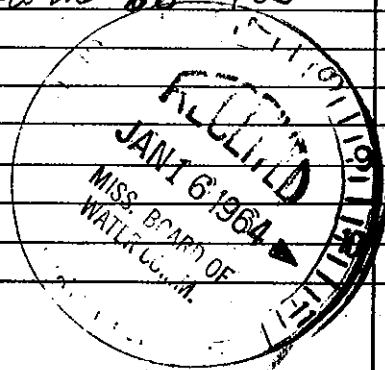

**CODED**

(Use Back Side)

Well No.

Mail this copy to Board of Water Commissioners 429 Miss. St. Jackson, Miss.