

CARROLL

MISSISSIPPI BOARD OF WATER COMMISSIONERS

F51

WATER WELL DRILLERS LOG


CODED

2-10-66

Date: 2-10, 1966, Driller: Smith Forge & Well Co. Carroll

(1) Owner of Land:	Description & Color of Materials Sand, Clay, Red Clay, Shell, etc.	Thick- ness Feet	Depth Feet
O. Mitchell (Name) Mc Carley Miss (Address)	Yellow Clay	4	4
(2) Location: SW 1/4, SW 1/4, Sec. 13 T18 R4E	Red white & yellow mixture	16	20
2 miles South, of Mc Carley (distance) (direction) (Nearest Town)	white clay	6	26
(3) Topography: Hilly (Hilly) (Flat) (Level)	brown clay		
(4) Purpose of Well: Domestic (Domestic Irrigation Municipal, Industrial, Other)	sand mixture	16	42
Information upon completion of well:	brown clay white mixture	5	47
(1) Diameter 2 inches.	Same as above	14	61
(2) Total Depth 135 feet.	Red rock cement	5"	
(3) Water Level 80 feet below top of ground.	black mixture	4	65
(4) Cased to 129, Size	blue clay black mixture	7	72
(5) Screen: Size 1/4, Length 6'	hard rock	8"	
(6) Were any formations sealed against pollution? yes, <input checked="" type="checkbox"/> no.	black gray shale	10	82
If YES depth of formation	rock	5"	
Why	black gray shale	20	102
Drillers Remarks: A very good well	hard pan shale fine		
	sand mixture	15	117
	gray sand with a few black spots	14	131

CODED

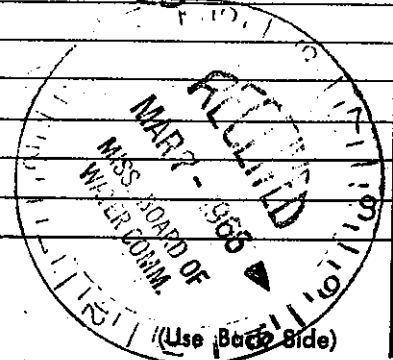

Well No. 2

Mail this copy to Board of Water Commissioners 429 Miss. St. Jackson, Miss.