


CARROLL MISSISSIPPI BOARD OF WATER COMMISSIONERS
F 52
4-66 **CODED**
WATER WELL DRILLERS LOG

Date: April, 1966, Driller: Jack Martin County Holmes
 (Name)

(1) Owner of Land: <u>W. H. Moland</u> (Name)	Description & Color of Materials Sand, Clay, Red Clay, Shell, etc.	Thick- ness Feet	Depth Feet
<u>Carrollton Miss</u> (Address)	<u>Clay</u>	<u>12</u>	<u>12</u>
(2) Location: <u>NW 1/4, NE 1/4, Sec. 5 T. 19 R. 4 E.</u>	<u>P. Clay</u>	<u>22</u>	<u>34</u>
<u>1 1/2</u> miles <u>NE</u> , of <u>Carrollton</u> (distance) (direction) (Nearest Town)	<u>P. Clay - mud</u>	<u>18</u>	<u>52</u>
(3) Topography: <u>Hilly</u> (Hilly) (Flat) (Level)	<u>Sand - mud</u>	<u>33</u>	<u>85</u>
(4) Purpose of Well: <u>Domestic</u> (Domestic Irrigation Municipal, Industrial, Other)	<u>Sand</u>	<u>25</u>	<u>110</u>
Information upon completion of well:	<u>Mud</u>	<u>42</u>	<u>152</u>
	<u>Sand</u>	<u>8</u>	<u>160</u>
	<u>mud</u>	<u>6</u>	<u>166</u>
	<u>Sand</u>	<u>24</u>	<u>190</u>
(1) Diameter <u>4</u> inches.	CODED		
(2) Total Depth <u>210</u> feet.			
(3) Water Level <u>105</u> feet below top of ground.			
(4) Cased to <u>180</u> , Size <u>4"</u>			
(5) Screen: Size <u>2"</u> , Length <u>10</u>			
(6) Were any formations sealed against pollution? _____ yes, _____ no.			
If YES depth of formation _____			
Why _____			
Drillers Remarks: _____			

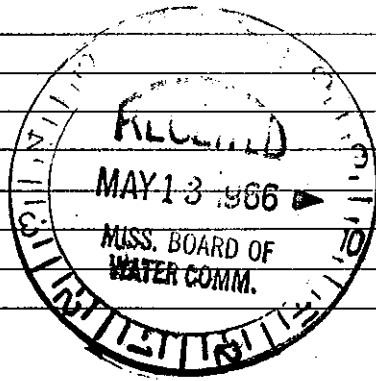

(Use Back Side)

Well No.

Mail this copy to Board of Water Commissioners 429 Miss. St. Jackson, Miss.