

Carroll
F53
10-66

MISSISSIPPI BOARD OF WATER COMMISSIONERS

WATER WELL DRILLERS LOG

CODED

Date: 10-19, 1966, Driller: Butane Gas Co. County Carroll
(Name)

(1) Owner of Land: James Slocum
(Name)
M^{rs} Carley, Miss.
(Address)

(2) Location: NW 1/4, SE 1/4, Sec. 9 T19R4E
2 miles E of N. Carroll
(distance) (direction) (Nearest Town)

(3) Topography: X
(Hilly) (Flat) (Level)

(4) Purpose of Well: Domestic
(Domestic Irrigation
Municipal, Industrial, Other)

Description & Color of Materials. Sand, Clay, Red Clay, Shell, etc.	Thick- ness Feet	Depth Feet
Clay	30	30
Spale	45	75
Green Sand	10	85
Spale	95	180
Green Sand	30	210

CODED

Information upon completion of well:

(1) Diameter: 4 3/4 inches.

(2) Total Depth: 210 feet.

(3) Water Level: 37' feet below top of ground.

(4) Cased to: 210, Size: 4" x 2"

(5) Screen: Size: 2", Length: 20'


(6) Were any formations sealed against pollution?
yes, X no.

If YES depth of formation _____

Why _____

Drillers Remarks: _____

CODED

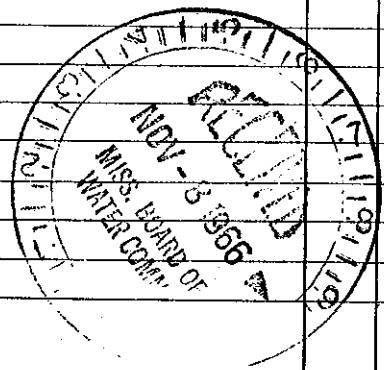

Well No.

(Use Back Side)

Retain this copy for your office files.