


Carroll  
F55  
4-67

MISSISSIPPI  
BOARD OF WATER COMMISSIONERS  
416 North State Street  
Jackson, Mississippi 39201  
WATER WELL DRILLERS LOG

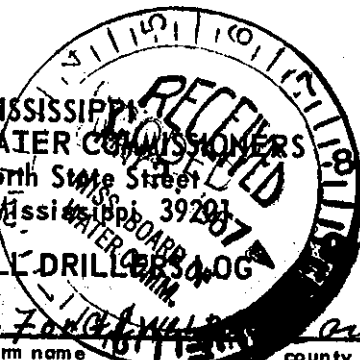

4-3 1967 Smith Ford Carroll  
date well completed firm name county well located

LANDOWNER: Simon Tatt

R 1 Box 85

McCarley, Miss  
(mailing address)

WELL LOCATION:

sec. 2 T 19 N R. H E  
7 W 1/4 S NE 1/4 W  
miles NE of Carlton  
(distance) (direction) (nearest town)

WELL PURPOSE: Home  
(home, irrigation, municipal, industrial)

WELL COMPLETION DATA:

- (1) diameter (inches) 4
- (2) total depth (feet) 352
- (3) static water level (feet) 60 below top of ground.
- (4) casing 1/2 galv. 315  
(material) (depth)  
1 1/4 if telescope see back.  
(size)
- (5) screen 6'  
(length) (depth to top)  
1 1/4 brass gauge  
(size) (material)
- (6) pump 3/4 hp about 350 gpm  
(HP) (yield gpm)  
Electric  
(type power)
- (7) electric log NO  
(yes or no)  
(organization running log)
- (8) how well bottom plugged

description of formations encountered	from	to
red clay	15	15
gray sand	10	25
red sand	5	30
iron rock	3	33
black clay	27	60
rock	1	61
black sand black clay mixture	9	70
black clay gray sand mixture	35	105
gray clay	3	108
gray sand clay mixture	12	120
black clay	7	127
gray sand clay mixture	50	177
black clay	5	182
black clay sand mixture	168	230
gray sand	12	242
black clay gray sand mixture	10	252
black clay	8	260
gray sand	5	268
gray sand clay mixture	72	340
gray sand	12	352

CODED

DRILLERS REMARKS: