

Carroll
F 56
4-67

MISSISSIPPI
BOARD OF WATER COMMISSIONERS
416 North State Street
Jackson, Mississippi 39201

CODED WATER WELL DRILLERS LOG

4-1-1967 date well completed
Smith Forge & Welding firm name
Carroll county well located


LANDOWNER: <u>William Stidger</u> <u>McCadley R2 Box 4</u> (mailing address)	description of formations encountered	from	to
	red clay	16	16
	red sand white clay mixture	5	21
	White Clay	5	26
	red sand	4	30
	thin white rock		
	white sand white clay mixture	80	110
	White sand	20	130
	white clay	2	132
	series of white rock		
	thin	12	144
	black clay	9	153
	white rock	9	162
	shell rock	16	172
	black sand shell		
	rock mixture	5	177
	Black clay	8	185
	rock	2	187
	gray sand	14	201
	blue sand blue		
	clay mixture	39	240
	fine blue sand	40	280
	rock	4	284
	sand blue clay		
	mixture	56	340
	good grad of		
	gray sand	20	360

WELL LOCATION:
sec. 27 T. 19 N. R. 4 E.
S SW 4 SW SW 4
4 miles S of Callion
(distance) (direction) (nearest town)

WELL PURPOSE: Home use
(home, irrigation, municipal, industrial)

WELL COMPLETION DATA:

- (1) diameter (inches) CODED
- (2) total depth (feet) 320
- (3) static water level (feet) 126 ^{below} top of ground.
- (4) casing 2" galv. ~~3"~~ 354
(material) (depth)
- 2 x 1 1/4" If telescope see back.
(size)
- (5) screen 6' 354
(length) (depth to top)
- 1 1/4" brass gauge
(size) (material)
- (6) pump 1/2 Red 260 HOUR
(HP) (yield gpm)
- Red
(type power)
- (7) electric log no
(yes or no)
- (organization running log)
- (8) how well bottom plugged CODED

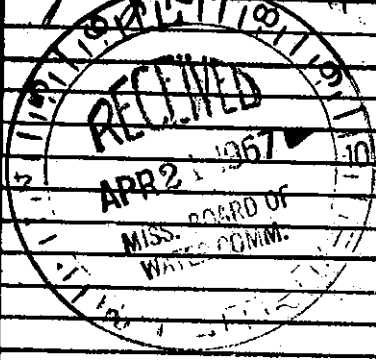

DRILLERS REMARKS: