


CARROLL MISSISSIPPI BOARD OF WATER COMMISSIONERS

67
5-2-62

CODED
WATER WELL DRILLERS LOG

Date: MAY 2, 1962, Driller: DELTA DRILLING Co. County CARROLL
(Name)

	Description & Color of Materials Sand, Clay, Red Clay, Shell, etc.	Thick- ness Feet	Depth Feet
(1) Owner of Land: <u>J. W. PERRY</u> (Name)	SAND	20	20
<u>RTE. 1, BOX 161, GREENWOOD, MISS.</u> (Address)	CLAY	66	86
(2) Location: <u>NE 1/4, NW 1/4, Sec. 34 T18R2E</u>	GRAVEL CODED	32	118
_____ miles _____ of _____ (distance) (direction) (Nearest Town)	GUMBO	57	175
(3) Topography: _____ (Hilly) (Flat) (Level)	SHALE	15	190
(4) Purpose of Well: <u>DOMESTIC</u> (Domestic Irrigation Municipal, Industrial, Other)	GUMBO	20	210
Information upon completion of well:	SAND	84	294
(1) Diameter <u>4</u> inches.	HARD SHALE	54	348
(2) Total Depth <u>577</u> feet.	GUMBO	22	370
(3) Water Level <u>75</u> feet below top of ground.	SAND w/5" ROCK	42	412
(4) Cased to <u>577</u> , Size <u>4 + 2</u>	SHALE	22	434
(5) Screen: Size <u>2"</u> , Length <u>10'</u>	SAND	41	475
(6) Were any formations sealed against pollution? _____ yes, <input checked="" type="checkbox"/> no.	GUMBO	22	497
If YES depth of formation _____	SHALE	46	543
Why _____	SAND	34	577
Drillers Remarks: <u>3/4 H.P. RED JACKET</u>	CODED		
<u>SUBMERSIBLE PUMP w/120 GAL</u>	CODED		
<u>TANK-SET 10.5' IN WELL.</u>	CODED		
	CODED		
	CODED		

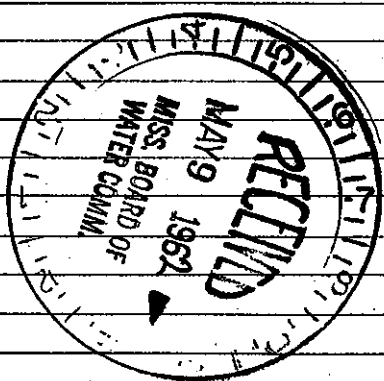

(Use Back Side)

Well No.

Mail this copy to Board of Water Commissioners 429 Miss. St. Jackson, Miss.