

**CARROLL** MISSISSIPPI BOARD OF WATER COMMISSIONERS

68

2-2-63

**WATER WELL DRILLERS LOG**

E 107 # 21

Date: FEB 2, 1963, Driller: DELTA DRILLING Co. County ~~MISSISSIPPI~~ CARROLL  
(Name)

		Description & Color of Materials Sand, Clay, Red Clay, Shell, etc.	Thick- ness Feet	Depth Feet
(1) Owner of Land: <u>DALTON ALFORD</u> (Name)		<u>CLAY</u>	<u>43</u>	<u>43</u>
<u>R. F. D. GREENWOOD, MISS.</u> (Address)		<u>RED SAND CODED</u>	<u>21</u>	<u>64</u>
(2) Location: <u>SW 1/4, SE 1/4, Sec. 27 T28R2E</u>		<u>GRAVEL</u>	<u>48</u>	<u>108</u>
_____ miles _____ of _____ (distance) (direction) (Nearest Town)		<u>RED SAND</u>	<u>106</u>	<u>214</u>
(3) Topography: _____ (Hilly) (Flat) (Level)		<u>BROWN SAND</u>	<u>107</u>	<u>321</u>
(4) Purpose of Well: <u>DOMESTIC</u> (Domestic Irrigation Municipal, Industrial, Other)		<u>GUMBO</u>	<u>61</u>	<u>382</u>
		<u>SHALE</u>	<u>22</u>	<u>404</u>
		<u>GREEN SAND</u>	<u>126</u>	<u>530</u>

Information upon completion of well:


- (1) Diameter 4 inches.
- (2) Total Depth 530 feet.
- (3) Water Level 127 feet below top of ground.
- (4) Cased to 510, Size 4" 249'  
2" 261'
- (5) Screen: Size 2", Length 20'  
PERFORATED PIPE
- (6) Were any formations sealed against pollution?  
\_\_\_\_\_ yes,  no.

If YES depth of formation \_\_\_\_\_

Why \_\_\_\_\_

Drillers Remarks: PUMP SETTING  
168' - 3/4 H.P. DEEP WELL  
SUBMERSIBLE PUMP WITH  
120 GAL. TANK -

CODED  
CODED

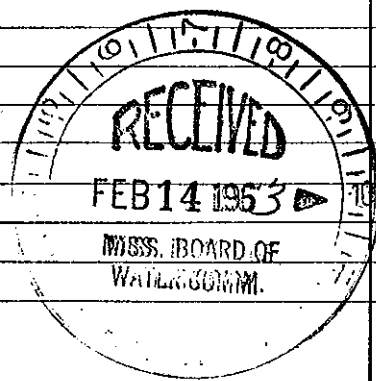

(Use Back Side)

Well No.

Mail this copy to Board of Water Commissioners 429 Miss. St. Jackson, Mis.