

CARROLL E-109 #22
MISSISSIPPI BOARD OF WATER COMMISSIONERS
WATER WELL DRILLERS LOG CODED

Date: OCT 5, 1962, Driller: DELTA DRILLING CO County CARROLL

(Name)

		Description & Color of Materials Sand, Clay, Red Clay, Shell, etc.	Thick- ness Feet	Depth Feet
(1) Owner of Land: <u>J. E. DAVES</u> (Name)		RED SAND	40	40
<u>BLACK HAWK, MISS</u> (Address)		GRAVEL	12	52
(2) Location: <u>NW 1/4, SE 1/4, Sec. 36 18 N 2 E</u> <u>T12N R2E</u>		RED SAND	34	86
<u>_____</u> miles, of <u>_____</u> (distance) (direction) (Nearest Town)		GUMBO	35	121
(3) Topography: <u>HILLY</u> (Hilly) (Flat) (Level)		SAND	70	191
(4) Purpose of Well: <u>DOMESTIC</u> (Domestic Irrigation Municipal, Industrial, Other)		GUMBO	64	255
		GREEN SAND w/10" ROCK	20	275
		GUMBO	15	290
		GREEN SAND	16	306
		SHALE	50	356
		GREEN SAND	110	466

Information upon completion of well:

- (1) Diameter 4 inches.
- (2) Total Depth 466 feet.
- (3) Water Level 3.5 feet below top of ground.
- (4) Cased to 440, Size 4x2"
- (5) Screen: Size 2", Length 46'
PERFORATED PIPE.
- (6) Were any formations sealed against pollution?
_____ yes, _____ no.

If YES depth of formation CODED


Why _____

Drillers Remarks: This Hole was Drilled

to 1100 ft. @ log run #22
3-9-63

CODED

CODED

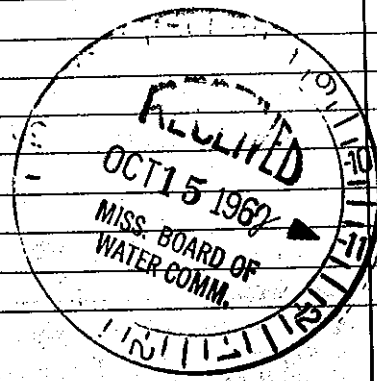

(Use Back Side)

Well No.

Mail this copy to Board of Water Commissioners 429 Miss. St. Jackson, Miss