

CARROLL MISSISSIPPI BOARD OF WATER COMMISSIONERS

G 11 E109 # 24  
 11-1-64 WATER WELL DRILLERS LOG

**CODED**


Date: NOV. 1, 1964, Drillers: DELTA DRILLING Co. County: CARROLL

(Name)

(1) Owner of Land: <u>D. J. M. ALFORD</u> (Name)	Description & Color of Materials Sand, Clay, Red Clay, Shell, etc.	Thick- ness Feet	Depth Feet
<u>RTE 1, GREENWOOD, MISS</u> (Address)	<u>RED CLAY</u>	<u>30</u>	<u>30</u>
(2) Location: <u>23 18-2</u> <u>1/4, 1/4, Sec. T R</u>	<u>GRAVEL</u>	<u>62</u>	<u>92</u>
_____ miles _____ of _____ (distance) (direction) (Nearest Town)	<u>SAND</u>	<u>90</u>	<u>182</u>
(3) Topography: _____ (Hilly) (Flat) (Level)	<u>CLAY</u>	<u>30</u>	<u>212</u>
(4) Purpose of Well: <u>DOMESTIC</u> (Domestic Irrigation Municipal, Industrial, Other)	<u>SAND</u>	<u>56</u>	<u>268</u>
Information upon completion of well:	<u>CLAY</u>	<u>80</u>	<u>348</u>
(1) Diameter <u>4</u> inches.	<u>SHALE W/ROCK</u>	<u>22</u>	<u>370</u>
(2) Total Depth <u>462</u> feet.	<u>GREEN SAND</u>	<u>20</u>	<u>390</u>
(3) Water Level _____ feet below top of ground.	<u>SHALE</u>	<u>12</u>	<u>402</u>
(4) Cased to <u>441</u> , Size <u>4" - 273</u> <u>2" - 168</u>	<u>SAND</u>	<u>16</u>	<u>418</u>
(5) Screen: Size <u>2"</u> , Length <u>21'</u> <u>PERFORATED PIPE</u>	<u>SHALE</u>	<u>8</u>	<u>426</u>
(6) Were any formations sealed against pollution? _____ yes, _____ no.	<u>SAND</u>	<u>36</u>	<u>462</u>

**CODED**

If YES depth of formation \_\_\_\_\_  
 Why \_\_\_\_\_  
 Drillers Remarks: 3/4 H.P. RED JACKET  
DEEP WELL SUMMERSIBLE PUMP  
SET IN WELL WITH 82 GAL  
TANK-

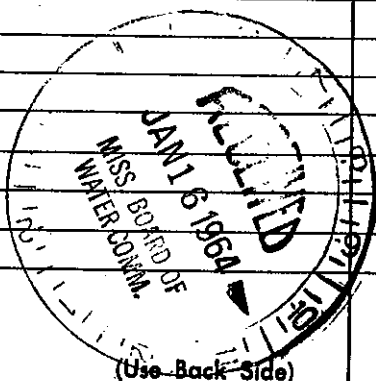

Well No. \_\_\_\_\_

Mail this copy to Board of Water Commissioners 429 Miss. St. Jackson, Miss