

CARROLL

MISSISSIPPI BOARD OF WATER COMMISSIONERS

612 E 109th 26

10-22-65 WATER WELL DRILLERS LOG

Date: OCT 22, 1965, Driller: DELTA DRILLING Co. County Carroll

(Name)

(1) Owner of Land: H.K. SAUCIER

(Name)

RT. 1, GREENWOOD, MISS

(Address)

(2) Location: NE 1/4, SW 1/4, Sec. 28 T18N R25E

_____ miles _____ of _____

(distance) (direction) (Nearest Town)

(3) Topography:

(Hilly) (Flat) (Level)

(4) Purpose of Well: Domestic

(Domestic Irrigation Municipal, Industrial, Other)

Description & Color of Materials Sand, Clay, Red Clay, Shell, etc.

Thick-ness Feet

Depth Feet

Description & Color of Materials	Thick-ness Feet	Depth Feet
Clay	60	60
Sand	66	126
Clay	118	244
Sand	20	264
CLAY	20	284
Sand	75	359
CLAY	22	381
Shale	83	464
Sand	20	484
Shale	10	494
Sand	44	538

Information upon completion of well:

(1) Diameter 4 inches.

(2) Total Depth 538 feet.

(3) Water Level _____ feet below top of ground.

(4) Cased to 528', Size 278'-2"

(5) Screen: Size 2", Length 10'

(6) Were any formations sealed against pollution?

_____ yes, _____ no.


If YES depth of formation _____

Why _____

Drillers Remarks: 3/4 H.P. RED JACKET

DEEP WELL SUBMERSIBLE

PUMP SET IN WELL.

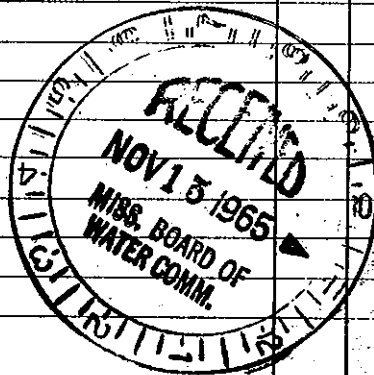

Well No.

(Use Back Side)

Mail this copy to Board of Water Commissioners 429 Miss. St. Jackson, Miss