

CARROLL MISSISSIPPI BOARD OF WATER COMMISSIONERS

OG 25
9-9-60

WATER WELL DRILLERS LOG

CODED

Date: 9-9, 1960, Driller: BUTANE GAS Co of GREENWOOD County ~~LETTING~~


(Name)

| (1) Owner of Land: <u>Mrs H.C. RUSSELL</u> (Name) | Description & Color of Materials Sand, Clay, Red Clay, Shell, etc. | Thick- ness Feet | Depth Feet |
|---|---|------------------------|---------------|
| <u>CARRLETON MISS.</u> (Address) | <u>RED CLAY</u> | <u>74</u> | <u>74</u> |
| (2) Location: <u>1/4</u> , <u>1/4</u> , Sec <u>13 18 R 2</u> | <u>RED SAND</u> | <u>20</u> | <u>96</u> |
| <u>10</u> miles <u>SOUTH</u> , of <u>CARRLETON</u> (distance) (direction) (Nearest Town) | <u>RED GRAVEL & SAND</u> | <u>64</u> | <u>160</u> |
| (3) Topography: <u>Hilly</u> (Hilly) (Flat) (Level) | <u>YELLOW CLAY</u> | <u>30</u> | <u>190</u> |
| (4) Purpose of Well: <u>DOMESTIC</u> (Domestic Irrigation Municipal, Industrial, Other) | <u>SHALE & BLUE CLAY</u> | <u>50</u> | <u>240</u> |
| | <u>RED SAND</u> | <u>53</u> | <u>295</u> |
| | <u>BLUE CLAY</u> | <u>55</u> | <u>350</u> |
| | <u>SHALE</u> | <u>51</u> | <u>401</u> |
| | <u>SAND GREEN</u> | <u>14</u> | <u>415</u> |
| | <u>ROCK</u> | <u>3</u> | <u>418</u> |
| | <u>SAND GREEN</u> | <u>32</u> | <u>450</u> |

Information upon completion of well:

- (1) Diameter 4 1/2" inches.
- (2) Total Depth 450 feet.
- (3) Water Level 175' feet below top of ground.
- (4) Cased to 450', Size 4" x 2"
- (5) Screen: Size 2", Length 20'
- (6) Were any formations sealed against pollution?
 yes, no.

CODED

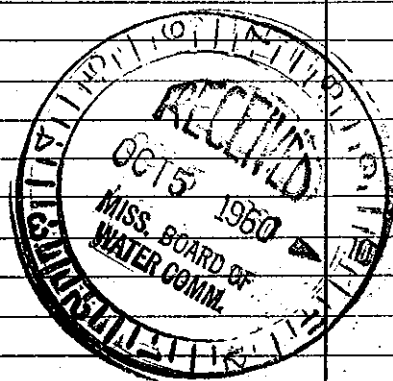

Well No.

(Use Back Side)

Mail this copy to Board of Water Commissioners 429 Miss. St. Jackson, Miss