

CARROLL  
G28  
11-4-65

MISSISSIPPI BOARD OF WATER COMMISSIONERS

WATER WELL DRILLERS LOG

**CODED**

Date: Nov. 4, 1965, Driller: DELTA DRILLING Co County CARROLL

(Name)

(1) Owner of Land: GUY L ALFORD  
(Name)  
RT. 1, GREENWOOD, MISS  
(Address)  
(2) Location: 26 18-2 1/4 Sec. T R  
\_\_\_\_\_ miles \_\_\_\_\_ of \_\_\_\_\_  
(distance) (direction) (Nearest Town)  
(3) Topography: \_\_\_\_\_  
(Hilly) (Flat) (Level)  
(4) Purpose of Well: Domestic  
(Domestic Irrigation  
Municipal, Industrial, Other)

Description & Color of Materials Sand, Clay, Red Clay, Shell, etc.	Thick- ness Feet	Depth Feet
Clay	34	34
Sand	32	66
Gravel	10	76
Sand	41	117
Clay	58	175
Sand	35	210
Clay	81	291
Shale w/ Rocks	38	329
Sand	91	420

Information upon completion of well:

(1) Diameter 4 inches.  
(2) Total Depth 420 feet.  
(3) Water Level 89 feet below top of ground.  
(4) Cased to 400, Size 250'-4" 150'-2 1/2"  
(5) Screen: Size 2", Length 20'  
Perforated Pipe  
(6) Were any formations sealed against pollution?  
\_\_\_\_\_ yes, \_\_\_\_\_ no.


**CODED**

If YES depth of formation \_\_\_\_\_

Why \_\_\_\_\_

Drillers Remarks: 3/4 H.P. Red Jacket

Deep Well Submersible pump  
Set 126' IN Well.

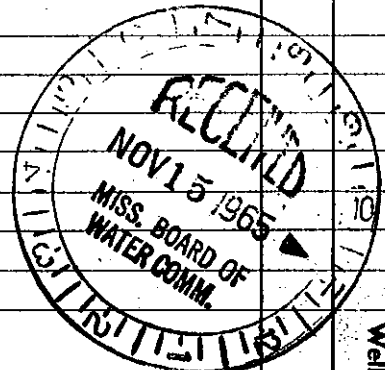

(Use Back Side)

Well No.

Mail this copy to Board of Water Commissioners 429 Miss. St. Jackson. Miss