

CARROLL

MISSISSIPPI BOARD OF WATER COMMISSIONERS

642


WATER WELL DRILLERS LOG

3-23-63

Date: MAR 23 1963, Driller: DELTA DRILLING Co. County CARROLL

(Name)

	Description & Color of Materials Sand, Clay, Red Clay, Shell, etc.	Thick- ness Feet	Depth Feet
(1) Owner of Land: <u>JOHN PERRY</u> (Name)	<u>CLAY</u>	<u>32</u>	<u>32</u>
<u>ROUTE 1, GREENWOOD, MISS.</u> (Address)	<u>SAND</u>	<u>242</u>	<u>274</u>
(2) Location: <u>SW 1/4, NW 1/4, Sec. 35 T18N R2 E</u>	<u>GUMBO W/ROCK</u>	<u>52</u>	<u>326</u>
_____ miles _____ of _____ (distance) (direction) (Nearest Town)	<u>SHALE W/ROCK</u>	<u>44</u>	<u>370</u>
(3) Topography: _____ (Hilly) (Flat) (Level)	<u>SAND</u>	<u>10</u>	<u>380</u>
(4) Purpose of Well: <u>DOMESTIC</u> (Domestic Irrigation Municipal, Industrial, Other)	<u>SHALE</u>	<u>22</u>	<u>402</u>
Information upon completion of well:	<u>SAND</u>	<u>48</u>	<u>450</u>
(1) Diameter <u>4</u> inches.	<u>CODED</u>		
(2) Total Depth <u>450</u> feet.			
(3) Water Level <u>60</u> feet below top of ground.			
(4) Cased to <u>430</u> , Size <u>4x2</u>			
(5) Screen: Size _____, Length _____	<u>CODED</u>		
(6) Were any formations sealed against pollution? _____ yes, _____ no.			
If YES depth of formation _____			
Why _____			
Drillers Remarks: <u>68' - Pump Setting</u>			

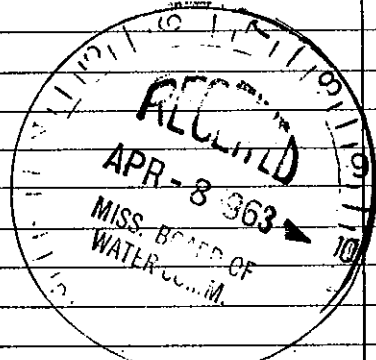

(Use Back Side)

Well No.

Mail this copy to Board of Water Commissioners 429 Miss. St. Jackson, Mis