

MISSISSIPPI BOARD OF WATER COMMISSIONERS

Carroll
G 43
5-66

WATER WELL DRILLERS LOG

CODED

Carroll

Date: May 27, 1966, Driller: Butane Gas Co. County: Before

(Name)

(1) Owner of Land: J. T. Acy
(Name)
Sidon, Miss.
(Address)

(2) Location: NE 1/4, SE 1/4, Sec. 20 T. 18 N. R. 2 E.
6 miles East of Sidon
(distance) (direction) (Nearest Town)

(3) Topography: Hilly
(Hilly) (Flat) (Level)

(4) Purpose of Well: Domestic
(Domestic Irrigation, Municipal, Industrial, Other)

Description & Color of Materials Sand, Clay, Red Clay, Shell, etc.	Thick- ness Feet	Depth Feet
Sandy clay	8	8
Sand & Gravel	24	32
Sand	8	40
Sandy clay	57	97
Sandy clay st.	62	159
Sandy clay	129	288
Hard shale	23	311
Rock	3	314
Hard shale	23	337
Sand shale st.	45	382
Shale sand st.	31	413
Sand	30	443
Shale	27	470

Information upon completion of well:

(1) Diameter 4 3/4 inches.

(2) Total Depth 470-0 feet.

(3) Water Level 12-6 feet below top of ground.

(4) Cased to 420, Size 2"

(5) Screen: Size 2", Length 20

(6) Were any formations sealed against pollution?
no yes, X no.

CODED

If YES depth of formation _____


Why _____

Drillers Remarks: CODED

9

Electric

None

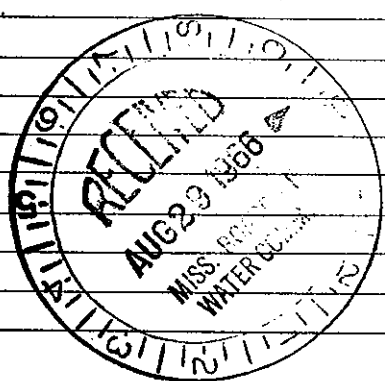

(Use Back Side)

Well No.

Retain this copy for your office files.