

MISSISSIPPI  
 BOARD OF WATER COMMISSIONERS  
 416 North State Street  
 Jackson, Mississippi 39201

WATER WELL DRILLERS LOG

Carroll  
 G44  
 12-66

date well completed 12-16-66 firm name Butane Gas Co of Wood county well located CARROLL

LANDOWNER: BEN PEACOCK  
Rt. 1 Sidon  
 (mailing address)

WELL LOCATION:  
 sec. 29 T. 18 N. R. 2 E.  
6 miles E of Sidon  
 (distance) (direction) (nearest town)

description of formations encountered	from	to
CLAY	0	10
SAND + GRAVEL	10	40
SHALE	40	60
SAND	60	84

CODED

WELL PURPOSE: Home  
 (home, irrigation, municipal, industrial)

WELL COMPLETION DATA:

(1) diameter (inches) 4 3/4

(2) total depth (feet) 84

(3) static water level (feet) 30 below above top of ground.

(4) casing Steel, 74  
 (material) (depth)  
2 If telescope see back.  
 (size)


(5) screen 10', 74'  
 (length) (depth to top)  
2", PVC  
 (size) (material)

(6) pump 1/2, 5  
 (HP) (yield gpm)  
Elec  
 (type power)

(7) electric log NO  
 (yes or no)  
 (organization running log)

(8) how well bottom plugged BRASS  
BACK WASH VALVE

CODED

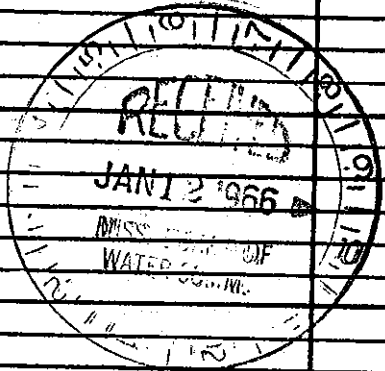

DRILLERS REMARKS: