

Carroll
G 45
1-67

MISSISSIPPI
BOARD OF WATER COMMISSIONERS
416 North State Street
Jackson, Mississippi 39201

WATER WELL DRILLERS LOG

1-10 1967 DELTA DRILLING CO. CARROLL
date well completed firm name county well located

LANDOWNER: J.B. CHAPMAN RT. 1 GREENWOOD, MISS (mailing address)	description of formations encountered	from	to
	CLAY	210	20'
	SAND	28	48
	CLAY	12	60
	Sand	46	106
	Shale	10	116
	CLAY	63	179
	Sand	21	200
	Clay	60	260
	Shale w/ROCKS-	25	285
	Sand	103	388

WELL LOCATION:


sec. 20 T. 18 N R. 2 E
8 miles SE of GREENWOOD
(distance) (direction) (nearest town)

WELL PURPOSE: DOMESTIC
(home, irrigation, municipal, industrial)

WELL COMPLETION DATA:

- (1) diameter (inches) 2
- (2) total depth (feet) 388
- (3) static water level (feet) FLOWS above top of ground.
- (4) casing BLK STEEL, 308 363
(material) (depth)
2 (size) if telescope see back.
- (5) screen 25 363
(length) (depth to top)
2" PERFORATED
(size) (material)
- (6) pump 1/3 100
(HP) (yield gpm)
ELEC.
(type power)
- (7) electric log NO
(yes or no)
(organization running log)
- (8) how well bottom plugged BACK PRESSURE VALVE

CODED

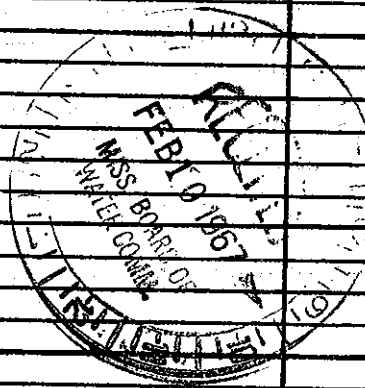

DRILLERS REMARKS: