

Carroll
G 49
2-68

MISSISSIPPI
BOARD OF WATER COMMISSIONERS
416 North State Street
Jackson, Mississippi 39201

CODED

WATER WELL DRILLERS LOG

2-8 1968 DYER WELL IRR. SER. CARROLL
date well completed firm name county well located

LANDOWNER: JOHN BANCIK
220 E. PRESIDENT
GREENWOOD, MISS.
(mailing address)


description of formations encountered	from	to
CLAY	0	65
SAND & GRAVEL	65	175
CLAY	175	175
SHALE & SAND	175	195
SAND	195	277
CLAY	277	365
SANDY SHALE	365	386
Bumpy SHALE	386	495
SAND	495	505
CLAY & SHALE	505	510
SAND	510	540

WELL LOCATION:
sec. 21 T. 16 N. R. 7 E
8 miles S.E. of G.WOOD
(distance) (direction) (nearest town)

WELL PURPOSE: HOME
(home, irrigation, municipal, industrial)

WELL COMPLETION DATA:
(1) diameter (inches) 4" x 2"
(2) total depth (feet) 540
(3) static water level (feet) 210' below top of ground.
(4) casing 4" BK 2" GALV. (material) (depth)
If telescope see back.
(size)
(5) screen 20' 520' (length) (depth to top)
2" STAINLESS STEEL (size) (material)
(6) pump 1 10 (HP) (yield gpm)
ELEC. (type power)
(7) electric log NO (yes or no)
(organization running log) BASIC WPAID
(8) how well bottom plugged VALVE

CODED

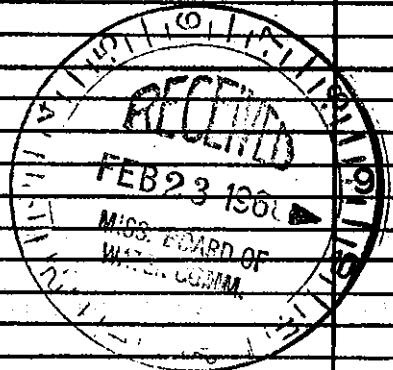

DRILLERS REMARKS: