

Canell
G A 53
7-68

MISSISSIPPI
BOARD OF WATER COMMISSIONERS
416 North State Street
Jackson, Mississippi 39201


CODED

WATER WELL DRILLERS LOG

JULY 29 1968 DELTA DRILLING Co CARROLL
date well completed firm name county well located

LANDOWNER: CHARLES WILLIAMSON	description of formations encountered	from	to
RT. 1, Box 251 GREENWOOD MISS. (mailing address)			
WELL LOCATION: SW/4 SE/4 sec 20 T 18 N R 2 E W	Sand	0	94
(distance) miles (direction) of (nearest town)	gumbo	94	105
WELL PURPOSE: DOMESTIC (home, irrigation, municipal, industrial)	Sand	105	146
WELL COMPLETION DATA:	Shale	146	170
(1) diameter (inches) 2"	gumbo	170	189
(2) total depth (feet) 336'	Shale	189	272
(3) static water level (feet) FLOWS below above top of ground.	green sand w/rock	272	290
(4) casing STEEL 311 (material) (depth)	SHALE	290	304
(size) If telescope see back.	green sand	304	336
(5) screen 25 311 (length) (depth to top)			
(size) PERFORATED PIPE (material)			
(6) pump 1/3 (HP) 10 (yield gpm)			
(type power) ELEC			
(7) electric log No (yes or no)			
(organization running log)			
(8) how well bottom plugged BACK PRESSURE VALVE			

CODED

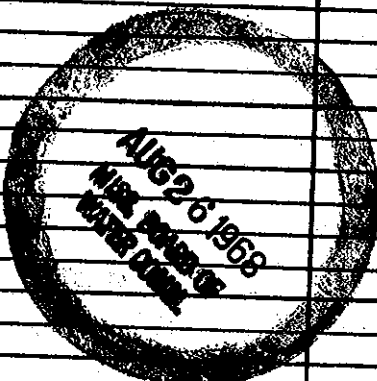

DRILLERS REMARKS: WELL FLOWS APPROX. 12 9 P.M.