

CARROLL

~~DEH~~

8-18-62

MISSISSIPPI BOARD OF WATER COMMISSIONERS

E-129 # 18

WATER WELL DRILLERS LOG

CODED

Date: AUG 18, 1962, Drillers DELTA DRILLING Co County CARROLL
(Name)

(1) Owner of Land: <u>J. D. MARSH</u> (Name)	Description & Color of Materials Sand, Clay, Red Clay, Shell, etc.	Thick- ness Feet	Depth Feet
<u>CARROLLTON, MISS.</u> (Address)	<u>CLAY</u>	<u>15</u>	<u>15</u>
(2) Location: <u>3 18 R 3</u>	<u>RED SAND</u>	<u>64</u>	<u>79</u>
_____ miles _____ of _____ (distance) (direction) (Nearest Town)	<u>GRAVEL</u>	<u>10</u>	<u>89</u>
(3) Topography: _____ (Hilly) (Flat) (Level)	<u>CLAY</u>	<u>112</u>	<u>201</u>
(4) Purpose of Well: <u>DAMESTIC</u> (Domestic Irrigation, Municipal, Industrial, Other)	<u>WHITE SAND</u>	<u>18</u>	<u>219</u>
	<u>SHALE</u>	<u>21</u>	<u>240</u>
	<u>GUMBO</u>	<u>8</u>	<u>248</u>
	<u>SHALE w/4" ROCK</u>	<u>29</u>	<u>277</u>
	<u>GUMBO</u>	<u>4</u>	<u>281</u>
	<u>GREEN SAND</u>	<u>81</u>	<u>362</u>

Information upon completion of well:


- (1) Diameter 4 inches.
- (2) Total Depth 362 feet.
- (3) Water Level 145 feet below top of ground.
- (4) Cased to 362, Size 4 4 2.
- (5) Screen: Size 2, Length 42'.
PERFORATED PIPE
- (6) Were any formations sealed against pollution?
_____ yes, _____ no.

If YES depth of formation _____

Why _____

Drillers Remarks: _____

CODED

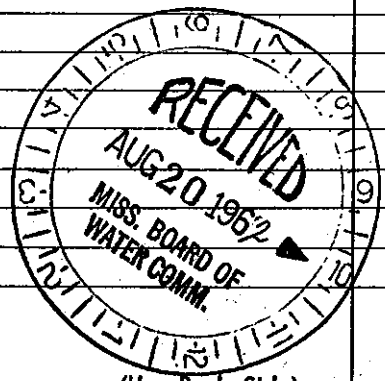

Well No. _____

Mail this copy to Board of Water Commissioners 429 Miss. St. Jackson, Miss