

H 9 CARROLL WATER WELL DRILLERS LOG CODED
6-4-65

Date: JUNE 4, 1965, Driller: DELTA DRILLING Co County CARROLL
 (Name)

	Description & Color of Materials Sand, Clay, Red Clay, Shell, etc.	Thick- ness Feet	Depth Feet
(1) Owner of Land: <u>D.B. LOTT</u> (Name) <u>RT 1, COILA, MISS</u> (Address)	<u>CLAY</u>	<u>60</u>	<u>60</u>
(2) Location: <u>1/4, 1/4, Sec. 24 T183</u> _____ miles _____, of _____ (distance) (direction) (Nearest Town)	<u>SAND</u>	<u>20</u>	<u>80</u>
(3) Topography: _____ (Hilly) (Flat) (Level)	<u>CLAY</u>	<u>40</u>	<u>120</u>
(4) Purpose of Well: <u>DOMESTIC</u> (Domestic Irrigation Municipal, Industrial, Other)	<u>SAND</u>	<u>100</u>	<u>220</u>

Information upon completion of well:

(1) Diameter 2 inches.

(2) Total Depth 220 feet.

(3) Water Level _____ feet below top of ground.

(4) Cased to 260, Size 2"

(5) Screen: Size 2", Length 10
2" SS SCREEN


(6) Were any formations sealed against pollution?
 _____ yes, _____ no.

If YES depth of formation _____

Why _____

Drillers Remarks: 1/2 H.P "MONITOR"
6" STROKE DEEP WELL
WORKING HEAD 1/42 GAL
GALV TANK SET IN WELL
WITH 1/8" WOOD ROD & 1-13/16"
EUREKA CYLINDER

CODED

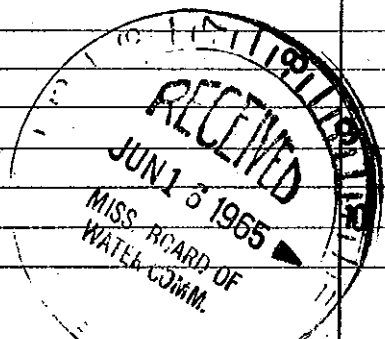

Well No. _____

(Use. Back. Side)

Mail this copy to Board of Water Commissioners 429 Miss. St. Jackson, Miss.