

CARROLL

MISSISSIPPI BOARD OF WATER COMMISSIONERS

H 29

6-66

WATER WELL DRILLERS LOG

CODED

Date: June, 1966, Driller: Jack Martin, County Holmes (Name)

(1) Owner of Land: <u>W. Gilmore</u> (Name)	Description & Color of Materials Sand, Clay, Red Clay, Shell, etc.	Thick- ness Feet	Depth Feet
<u>Carrollton</u> (Address)	Clay	14	14
(2) Location: <u>SE 1/4, NE 1/4, Sec. 3 T18R32E</u>	Sand	34	48
<u>4</u> miles <u>SW</u> , of <u>Carrollton</u> (distance) (direction) (Nearest Town)	Sand-gravel	66	114
(3) Topography: <u>Hilly</u> (Hilly) (Flat) (Level)	Sand	86	200
(4) Purpose of Well: <u>Domestic</u> (Domestic Irrigation Municipal, Industrial, Other)	CODED		


Information upon completion of well:

- (1) Diameter 2 inches.
- (2) Total Depth 200 feet.
- (3) Water Level 132 feet below top of ground.
- (4) Cased to 195, Size 2.
- (5) Screen: Size 2, Length 5.
- (6) Were any formations sealed against pollution?
_____ yes, _____ no.

If YES depth of formation _____

Why _____

Drillers Remarks: _____

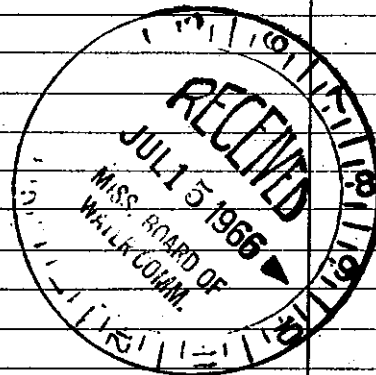

Well No.

(Use Back Side)

Mail this copy to Board of Water Commissioners 429 Miss. St. Jackson, Miss.