

CODED

MISSISSIPPI BOARD OF WATER COMMISSIONERS
416 North State Street
Jackson, Mississippi 39201

WATER WELL DRILLERS LOG

Carroll
H 31
10-67

October 1967 Jack Martin Carroll
date well completed firm name county well located

LANDOWNER: Clairborne McDaniel

description of formations encountered

from

to

Coila

Clay

0

16

Rt A 1

Sand

16

62

(mailing address)

WELL LOCATION:

sec. 15 T 18 N R 3 E

1 1/2 miles N of Coila
(distance) (direction) (nearest town)

Pipe Clay

62

73

pipe clay sand

73

89

Sand

89

115

WELL PURPOSE: Home
(home, irrigation, municipal, industrial)

Mud

115

212

WELL COMPLETION DATA:

(1) diameter (inches) 2

Sand

212

250

(2) total depth (feet) 250

(3) static water level (feet) 140 below top of ground.

(4) casing Steel, 245
(material) (depth)

2 if telescope see back.
(size)

(5) screen 5, 245
(length) (depth to top)

2, Stainless Steel
(size) (material)

(6) pump 3/4 3
(HP) (yield gpm)


Electric
(type power)

(7) electric log No
(yes or no)

(organization running log)

(8) how well bottom plugged Cas

CODED

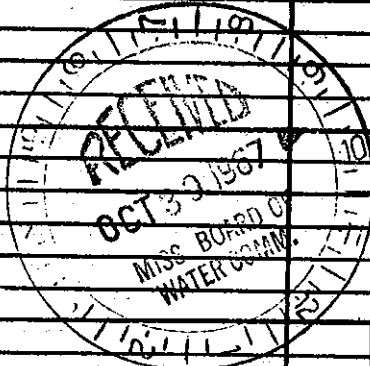

DRILLERS REMARKS: