

Carroll

H32

2-68

MISSISSIPPI CODED
 BOARD OF WATER COMMISSIONERS
 416 North State Street
 Jackson, Mississippi 39201

WATER WELL DRILLERS LOG

date well completed 19 Butade Gas Co. of Greenwood firm name CARROLL county well located

LANDOWNER:

J. P. Harmon

CARROLLTON, Miss.
 (mailing address)

WELL LOCATION:

sec. 2 T. 18 N R. 3 E
3 miles S of CARROLLTON
 (distance) (direction) (nearest town)

WELL PURPOSE: Home
 (home, irrigation, municipal, industrial)

WELL COMPLETION DATA:


- (1) diameter (inches) 4 3/4
- (2) total depth (feet) 397
- (3) static water level (feet) 72 below top of ground.
- (4) casing Steel, 321,
 (material) (depth)
4 X 2 If telescope see back.
 (size)
- (5) screen 20, 321
 (length) (depth to top)
2, Stainless Steel
 (size) (material)
- (6) pump 3/4, 8
 (HP) (yield gpm)
Elec.
 (type power)
- (7) electric log NO
 (yes or no)
 (organization running log)
- (8) how well bottom plugged
BACK PRESSURE VALVE

description of formations encountered

from to

CLAY	0	16
SANDY CLAY	16	46
CREAM COLORED SAND	46	135
SHALE	135	187
GREEN SAND + SHALE	187	231
SHALE	231	258
SAND + SHALE	258	321
SAND	321	341
SHALE	341	397

CODED

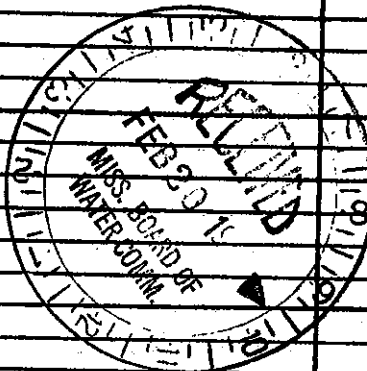

DRILLERS REMARKS: W.G.