

State Well Report

Part 1 – Driller's Log

Mississippi Department of Environmental Quality
Office of Land and Water Resources
P.O. Box 10631
Jackson, MS 39289-0631
(601)961-5210
(601)354-6938 (fax)

County: CARROLL
 Permit #: _____
 Driller: RATLIFF WATERWELL
 Date drilling completed: 2-16-15

For Office Use Only:

Aquifer: _____
 Well #: 41
 L. S. Elevation: _____
 E-log #: _____

State Law requires that this report be prepared by the license holder responsible for the work and filed with the Department at the above address within 30 days of completion of drilling of the well or borehole.

Information on Well Owner <i>(Landowner if borehole is not for a water well)</i>	Well or Borehole Location
Owner Name: <u>Jimmy Oliver</u>	Latitude: <u>N 33° 24' 06.9"</u> Longitude: <u>W 089° 56' 35.1"</u>
Mailing Address: <u>247 Hoxton Road</u>	Method of Lat/Long (circle one): Conventional Survey, _____
<u>Greenville Ms. 38703</u>	USGS quad: <u>Hand-held GPS</u> , Survey-grade GPS _____
City State Zip Code	<u>SW 1/4 SW 1/4 Sec 25 Twn 18N Rng 3E</u>
Telephone No. () _____	Distance: <u>7</u> Miles Direction: <u>South</u> of Nearest Town: <u>CARROLLTON</u>

Well / Borehole Data

Date drilling started: 2-16-15 Date drilling completed: 2-16-15 Hole depth: 230' Hole diameter: 7 1/4"

Location of the source of any surface water used for drilling: Community

Method of dosing and volume of Chlorine used in drilling and development: 50 ppm

Logs run (circle all applicable): No log run Electric Gamma Ray Density Sonic Neutron Other: _____

Name of organization running log(s): _____

Purpose of borehole (check one): Water Well Geotechnical/Geological Investigation _____ Ground Source Heat Pump _____

Seismic Survey _____ Other (describe) _____

If drilling is not related to water well construction, skip the remainder of this block

Purpose of Well (check one): Home Industrial _____ Public Supply _____ Irrigation _____ Fish Culture _____ Other: _____

If a flowing well, method of flow regulation: Valve _____ Other (describe) _____

Static Water Level: 122 feet above or below (circle one) land surface Date measured: 2-17-15

Method of Measurement (circle one) steel tape electric tape air line other: _____

Well depth: 220 Well grouted to a depth of 10 feet Type of grout (circle one): Neat Cement Bentonite Mix

Casing length: 200 feet Casing diameter: 4 inches Type of casing: PVC

Screen length: 20 feet Screen diameter: 4 inches Type of screen: PVC

Screen slot size: .013 inches Setting depth: From 200 feet to 220 feet

Type of completion (circle all applicable): Gravel packed Underreamed Telescoped Open hole Natural Development

Other (describe): _____


Top of lap pipe or reduction in casing: _____ feet. *If telescoped or more than one screen, describe on next page*

H41

The sketch below only required for water wells

Description of formations encountered must be provided for all wells and boreholes, unless specifically exempted by regulations

If well telescopes, show depths on sketch.

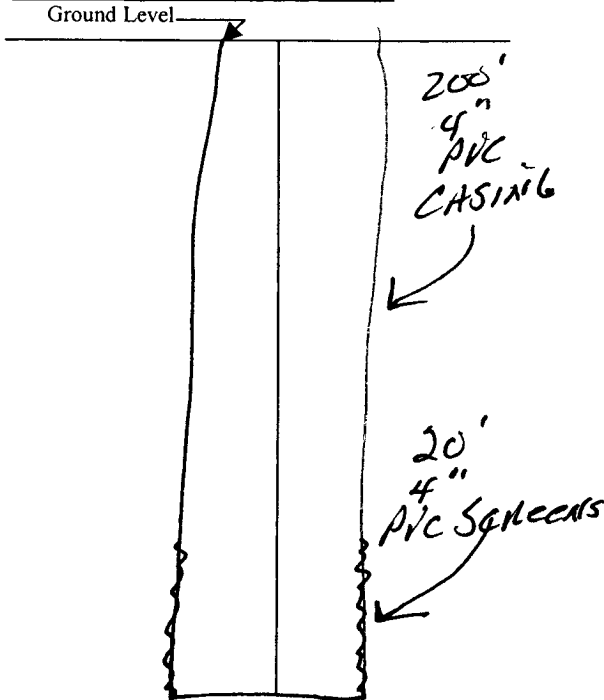

Description of Formations Encountered	From (depth)	To (depth)
CLAY	Ground Level	15
Red SAND	15	50
CLAY	50	80
COARSE SAND	80	220
SANDY CLAY	220	280

If more than one screen, show location of each on sketch

Sketch the property layout and include the following: 1) the well location; 2) any permanent structures on the property that may aid in locating the well; 3) any roads, power lines, or other items that may aid in locating the property and the well; 4) a north arrow.

See ATTACHED MAP

RECEIVED
DEC 09 2015
PL-01015

Landowner Name: Jimmy Oliver

Form: OLWR-SWR-1A

I certify that the well/borehole was drilled, constructed, and completed in accordance with all applicable requirements of the Mississippi Department of Environmental Quality and the Mississippi Department of Health regulations, if applicable, and state laws.

Robert E. Ratliff 0-002 3-3-15
Print Name of Responsible Licensee and License No. Date

Robert E. Ratliff
Signature of Licensee

STATE WELL REPORT

Part 2

Pump Installer's Completion Report
 Mississippi Department of Environmental Quality
 Office of Land and Water Resources
 P.O. Box 2309
 Jackson, MS 39225-2309
 (601)961-5210
 (601) 360-0535 (fax)

For Office Use Only:

Well #: 441

Aquifer: _____

County: CARROLL
 Permit #: _____
 Driller: KATLIFF WATER WELL
 Date completed: 2-20-15
Copy information from block on Part 1

This part of the report must be completed by a licensed water well contractor or a licensed pump installer. A copy of Part 1 of the report must be attached and both parts filed with the Department at the above address within 30 days of well completion.

Well Owner Information	Well Location
Owner Name: <u>Jimmy Oliver</u>	Latitude: <u>33° 24' 06.9"</u> Longitude: <u>1089° 56' 35.1"</u>
Mailing Address: <u>247 Hoxton Road</u>	Method of Lat/Long (check one): Conventional Survey _____, USGS quad _____, Survey-grade GPS _____
<u>Greenville</u> <u>Ms.</u> <u>38703</u>	1/4 _____ 1/4, Sec <u>25</u> T <u>18W</u> R <u>3E</u>
City State Zip Code	<u>7</u> Miles <u>South</u> of <u>CAMMOTON</u>
Telephone No. (____) _____	(Distance) (Direction) (Nearest Town)

Pump Type (circle one)

Submersible Turbine Air Lift Centrifugal Flowing Well Jet Piston Rotary Other (describe): _____

Date Pump Installed: 2-20-15 Rated Pump Capacity: 18 Gallons Per Minute

Is This Pump (circle one): New Repaired Replacement

Power Type (circle one)

Electric Diesel Gasoline Natural Gas Tractor PTO Windmill Other (describe): _____

Horse Power Rating of Motor: 1 Setting Depth: 200 feet Number of Stages: 15

Pump Test Data for Non Flowing Well

Date Well Tested: 2-20-15 Duration of Pump Test (minimum 4 hours): 4 hours

Static Water Level (A): 122 Feet Below Land Surface Pumping Water Level (B): 180 Feet Below Land Surface

Drawdown [(B) - (A)]: 58 Feet Below Land Surface Test Pumping Rate: 15 Gallons Per Minute

Method of measurement (circle one): Steel tape Electric tape Air line Other (describe): _____

Pump Test Data for Flowing Well

Measured shut in head: _____ feet.

Well yielded 15 GPM with a drawdown of 58 feet after 4 hours of pumping

Meter Installation

Meter Manufacturer: _____ Meter Serial Number: _____

Meter Model Number/Name: _____ Type of Meter: _____

Totalizer Register Unit and Multiplier Factor (AF x .001, gal x 1000, etc): _____

Installation Date: _____ Meter installed by: _____

Is This Meter (circle one): New Repaired Replacement

Important: By submitting the above information you are certifying that this meter was installed to manufacturer standards. For agricultural wells, a list of approved meters is on the MDEQ website.

I HEREBY CERTIFY that the above statements are true to the best of my knowledge.

Robert C Katliff 0-002 3-3-15 Robert C Katliff

Print Name of Pump Installer and License No. (if applicable) Date Signature of Pump Installer