

CARROLL

J /

11-20-61

MISSISSIPPI BOARD OF WATER COMMISSIONERS

WATER WELL DRILLERS LOG

J /

6

Carroll

Date: 11-20, 1961, Driller: Jack Martin County ~~Holmes~~ Carroll

(Name)

(1) Owner of Land: <u>R. M. Read</u> (Name)	Description & Color of Materials Sand, Clay, Red Clay, Shell, etc.	Thick- ness Feet	Depth Feet
<u>Vaiden (Carroll County)</u> (Address)	<u>Red clay</u>	<u>4</u>	<u>4</u>
<u>SE</u> (Address)	<u>Purple clay (white)</u>	<u>32</u>	<u>36</u>
(2) Location: <u>NE 1/4, SE 1/4, Sec. 25 T18R4E</u>	<u>Purple clay (dark)</u>	<u>14</u>	<u>50</u>
<u>7</u> miles <u>NW</u> , of <u>Vaiden</u> (distance) (direction) (Nearest Town)	<u>Sand (fine)</u>		
(3) Topography: <u>Hilly</u> (Hilly) (Flat) (Level)	<u>with pipe clay</u>	<u>50</u>	<u>100</u>
(4) Purpose of Well: <u>Domestic</u> (Domestic Irrigation Municipal, Industrial, Other)	<u>Sand</u>	<u>20</u>	<u>120</u>

Information upon completion of well:

- (1) Diameter 2 inches.
- (2) Total Depth 120 feet.
- (3) Water Level 60 feet below top of ground.
- (4) Cased to 115', Size 2
- (5) Screen: Size 2, Length 5ft
- (6) Were any formations sealed against pollution?
_____ yes, _____ no.


If YES depth of formation _____

Why _____

Drillers Remarks: _____

CODED

CODED

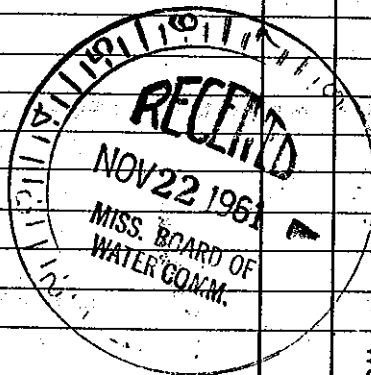

Well No.

(Use Back Side)

Mail this copy to Board of Water Commissioners 429 Miss. St. Jackson, Miss