

CARROLL

MISSISSIPPI BOARD OF WATER COMMISSIONERS

F ?

JHJ
6-20-60

WATER WELL DRILLERS LOG

CODED

Date: 6-20, 1960, Driller: DELTA DRILLING Co County: EFFORE

(Name)

(1) Owner of Land: JOHN T. WARE
(Name)

RTE. 3, CARROLLTON, MISS
(Address)

(2) Location: 20 18-4
_____ 1/4, _____ 1/4, Sec. _____ T. R.

_____ miles _____ of _____
(distance) (direction) (Nearest Town)

(3) Topography: _____
(Hilly) (Flat) (Level)

(4) Purpose of Well: DOMESTIC
(Domestic Irrigation
Municipal, Industrial, Other)

Description & Color of Materials Sand, Clay, Red Clay, Shell, etc.	Thick- ness Feet	Depth Feet
CLAY	12	12
SAND	15	27
SHALE	15	42
SAND	82	124
SHALE w/CLAY STREAKS	36	160
COARSE GREEN SAND	30	190
SHALE	5	195

Information upon completion of well:

(1) Diameter 2 inches.


(2) Total Depth 195 feet.

(3) Water Level 58 feet below top of ground.

(4) Cased to 185, Size 2"

(5) Screen: Size 2, Length 10

(6) Were any formations sealed against pollution?
_____ yes, _____ no.

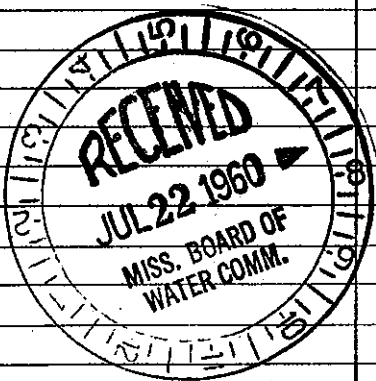

If YES depth of formation _____

Why _____

Drillers Remarks: _____

(Use Back Side)

Well No.

Mail this copy to Board of Water Commissioners 429 Miss. St. Jackson, Miss