

MISSISSIPPI BOARD OF WATER COMMISSIONERS

CARROLL
J 13
S-19-66

WATER WELL DRILLERS LOG

CODED

Date: May 19, 1966, Driller: Butane Gas Co. County: Leflore

(Name)


(1) Owner of Land: Big Hungry Hunting Club
(Name)
Carrollton, Miss.
(Address)

(2) Location: 1/4, 1/4, Sec. 30 T. 18 R. 4,
8 miles S E of Carrollton
(distance) (direction) (Nearest Town)

(3) Topography: Hilly
(Hilly) (Flat) (Level)

(4) Purpose of Well: Domestic
(Domestic Irrigation
Municipal, Industrial, Other)

Description & Color of Materials Sand, Clay, Red Clay, Shell, etc.	Thick- ness Feet	Depth Feet
Hard Sandy Clay	8	8
Soft Sandy Clay	50	58
Hard Shale	19	87
Sand & Clay St.	167	254

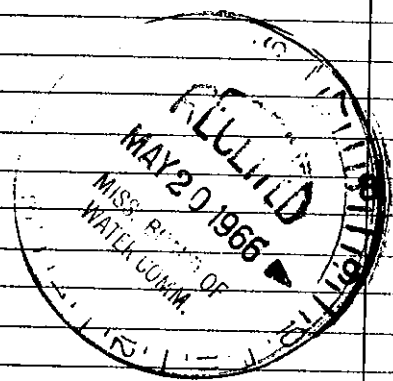

CODED

Information upon completion of well:

(1) Diameter: 6 3/4 inches.

(2) Total Depth: 254' feet.

(3) Water Level: 141 feet below top of ground.

(4) Cased to: 220, Size: 4"

(5) Screen: Size: 4, Length: 7'-8"

(6) Were any formations sealed against pollution?
_____ yes, _____ no.

If YES depth of formation _____

Why _____

Drillers Remarks: _____

Well No.

(Use Back Side)

Retain this copy for your office files.