


CARROLL MISSISSIPPI BOARD OF WATER COMMISSIONERS

J16
3-25-63

WATER WELL DRILLERS LOG

Date: MAR 25, 1963, Driller: DELTA DRILLING Co County: CARROLL
(Name)

(1) Owner of Land: <u>LEWIS CHAMBLESS</u> (Name)	Description & Color of Materials Sand, Clay, Red Clay, Shell, etc.	Thick- ness Feet	Depth Feet
<u>GREENWOOD, MISS.</u> (Address)	<u>RED CLAY</u>	<u>30</u>	<u>30</u>
(2) Location: <u>NW 1/4, SW 1/4, Sec. 15 T10R4E</u>	<u>SAND</u>	<u>46</u>	<u>76</u>
_____ miles _____ of _____ (distance) (direction) (Nearest Town)	<u>SHALE</u>	<u>28</u>	<u>104</u>
(3) Topography: _____ (Hilly) (Flat) (Level)	<u>SAND</u>	<u>67</u>	<u>171</u>
(4) Purpose of Well: <u>DOMESTIC</u> (Domestic Irrigation Municipal, Industrial, Other)			
Information upon completion of well:			
(1) Diameter <u>2</u> inches.	CODED		
(2) Total Depth <u>168</u> feet.			
(3) Water Level _____ feet below top of ground.			
(4) Cased to <u>148</u> , Size <u>2</u>			
(5) Screen: Size <u>2"</u> , Length <u>20'</u> <u>PERFORATED PIPE</u>	CODED		
(6) Were any formations sealed against pollution? _____ yes, _____ no.			
If YES depth of formation _____			
Why _____			
Drillers Remarks: _____			

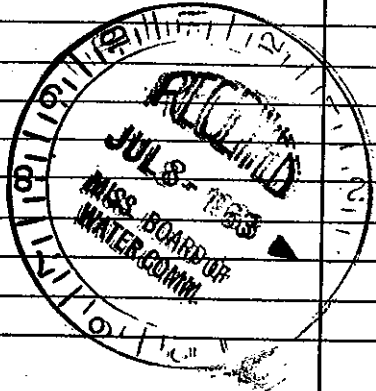

Well No.

(Use Back Side)

Mail this copy to Board of Water Commissioners 429 Miss. St. Jackson, Miss.