

CARROLL MISSISSIPPI BOARD OF WATER COMMISSIONERS

J 18  
1-28-66

WATER WELL DRILLERS LOG

**CODED**

Date: JAN 28, 1966, Driller: DELTA DRIVING Co. County: CARROLL  
(Name)

(1) Owner of Land: G. R. SIMPSON  
WELL LOCATION: RE. D. CARROLLTON  
(Address) 12 18-4  
(2) Location: 1/4, 1/4, Sec. T R  
\_\_\_\_\_ miles \_\_\_\_\_ of \_\_\_\_\_  
(distance) (direction) (Nearest Town)  
(3) Topography: \_\_\_\_\_  
(Hilly) (Flat) (Level)  
(4) Purpose of Well: DOMESTIC  
(Domestic Irrigation  
Municipal, Industrial, Other)

Description & Color of Materials Sand, Clay, Red Clay, Shell, etc.	Thick- ness Feet	Depth Feet
Clay	30	30
gumbo	64	104
Sand w/ Rock - gravel	31	135
gumbo	13	148
gumbo	21	169
Green Sand w/ Rock	13	182
Red Sand w/ Rock	24	206
Clay	26	232
Shale	14	246
Sand w/ Shale	28	274

Information upon completion of well:


(1) Diameter 4" inches.  
(2) Total Depth 274 feet.  
(3) Water Level 58 feet below top of ground.  
126'  
(4) Cased to 126', Size 4"  
(5) Screen: Size 2", Length 20'  
(6) Were any formations sealed against pollution?  
\_\_\_\_\_ yes, \_\_\_\_\_ no.

If YES depth of formation \_\_\_\_\_

Why \_\_\_\_\_

Drillers Remarks: 84' pump setting  
WELL SET 126'

**CODED**

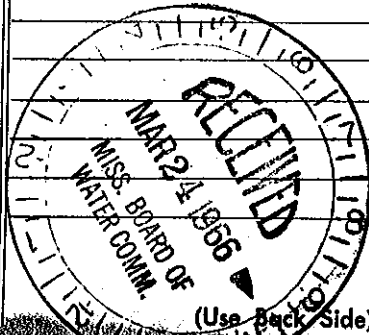

Well No. \_\_\_\_\_

Mail this copy to Board of Water Commissioners, 429 S. St. Jackson, Miss.