

CARROLL
J21
3-13-74

MISSISSIPPI
BOARD OF WATER COMMISSIONERS
416 North State Street
Jackson, Mississippi 39201

CODED


WATER WELL DRILLERS LOG

CARROLL

3-13 1974 THOMAS & SON
date well completed firm name county well located

LANDOWNER	description of formations encountered	from	to
Day / Carpenter			
CARROLLTON, Miss.	DIRT	0	33
(mailing address)	CHALK + DIRT + SAND	33	129
	BLACK DIRT	121	138
WELL LOCATION:	ROCK	138	147
sec. 8 T. 18 N. R. 40 E	Green SAND	147	182
4 1/2 miles SE of CARROLLTON			
(distance) (direction) (nearest town)			
WELL PURPOSE:			
(Home, irrigation, municipal, industrial)			
WELL COMPLETION DATA:			
(1) diameter (Inches) 2			
(2) total depth (feet) 182			
(3) static water level (feet) 115 ^{below} _{above} top of ground			
(4) casing (material) (depth) 138			
2 (size) if telescope see back.			
(5) screen (length) (depth to top) open			
(size) (material)			
(6) pump (HP) (yield gpm) 2 8			
(type power) elec.			
(7) electric log (yes or no) no			
(organization running log)			
(8) how well bottom plugged open			
DRILLERS REMARKS:			

CODED

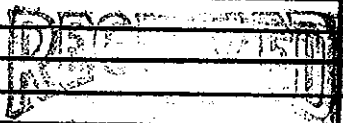

MAY 22 1974

MISS. BD. OF WATER COMM