

Carroll

MISSISSIPPI BOARD OF WATER COMMISSIONERS

T 23  
10-66

WATER WELL DRILLERS LOG

Date: 10-26, 1966, Driller: BUTANE GAS CO. County: CARROLL

(Name)

(1) Owner of Land: <u>C. S. Whittington</u> (Name)	Description & Color of Materials Sand, Clay, Red Clay, Shell, etc.	Thick- ness Feet	Depth Feet
<u>RT. 3, Winona, Miss.</u> (Address)	<u>Clay</u>	<u>84</u>	<u>84</u>
(2) Location: <u>SW 1/4, SE 1/4, Sec 24 T18R4E</u>	<u>Sand + Clay</u>	<u>11</u>	<u>95</u>
<u>6</u> miles <u>NW</u> , of <u>Vaiden</u> (distance) (direction) (Nearest Town)	<u>White Sand</u>	<u>35</u>	<u>130</u>
(3) Topography: <input checked="" type="checkbox"/> (Hilly) <input type="checkbox"/> (Flat) <input type="checkbox"/> (Level)			
(4) Purpose of Well: <u>Domestic</u> (Domestic Irrigation, Municipal, Industrial, Other)			

Information upon completion of well:

- (1) Diameter 4 3/4 inches.
- (2) Total Depth 130 feet.
- (3) Water Level 70' feet below top of ground.
- (4) Cased to 125, Size 2"
- (5) Screen: Size 2", Length 10'
- (6) Were any formations sealed against pollution?  
yes,  no.


If YES depth of formation \_\_\_\_\_

Why \_\_\_\_\_

Drillers Remarks: \_\_\_\_\_

CODED

CODED

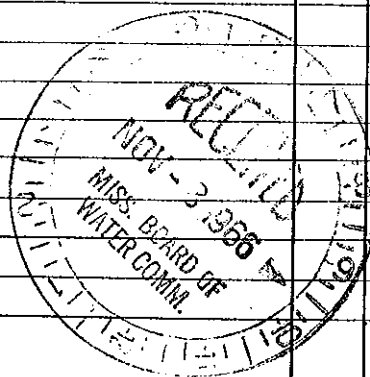

Well No. \_\_\_\_\_

(Use Back Side)

Retain this copy for your office files.