

CARROLL MISSISSIPPI BOARD OF WATER COMMISSIONERS

K 2
12-60

WATER WELL DRILLERS LOG **CODED**

~~K 300~~
K 2
Carroll
Holmes

Date: Dec, 1960, Driller: Jack Martin County Holmes
(Name)


(1) Owner of Land: J. E. Ellis
(Name)
Winona
(Address)
NE (Address)
(2) Location: NW 1/4, SW 1/4, Sec. 26 T18R5E
4 miles North, of Vaiden
(distance) (direction) (Nearest Town)
(3) Topography: Hilly
(Hilly) (Flat) (Level)
(4) Purpose of Well: Domestic
(Domestic Irrigation
Municipal, Industrial, Other)

Description & Color of Materials Sand, Clay, Red Clay, Shell, etc.	Thick- ness Feet	Depth Feet
Clay	19	19
Sand	27	46
Mud + Sand	4	50
Fine grain green Sand	32	82
Mud	47	129
rock	2	131
Mud - thin rock layers	17	148
Sand	9	157
S-Mud + Sand	18	175
Mud	20	195
Mud - rock layers	9	199
Sand	8	207
Mud - Sand streaks	70	277
Coarse Sand	38	315

Information upon completion of well:

(1) Diameter 2 inches.
(2) Total Depth 310 feet.
(3) Water Level 61 feet below top of ground.
(4) Cased to 300, Size 2
(5) Screen: Size 2", Length 10 ft
(6) Were any formations sealed against pollution?
_____ yes, no.

CODED

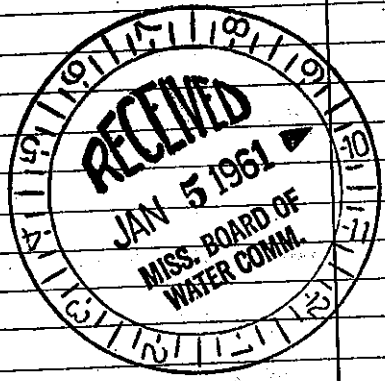

If YES depth of formation _____
Why _____
Drillers Remarks: _____

Well No.

(Use Back Side)

Mail this copy to Board of Water Commissioners 429 Miss. St. Jackson, Miss.