

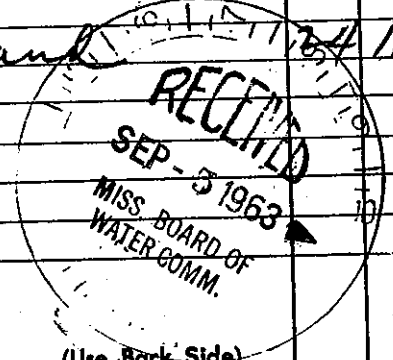
CARROLL MISSISSIPPI BOARD OF WATER COMMISSIONERS

K 7
8-63

WATER WELL DRILLERS LOG

Date: Aug, 1963, Driller: Jack Martin County Carroll
(Name)

CODED

(1) Owner of Land: <u>Vernon Welch</u> (Name)	Description & Color of Materials Sand, Clay, Red Clay, Shell, etc.	Thick- ness Feet	Depth Feet
<u>Warden</u> (Address)	<u>Clay</u>	<u>19</u>	<u>19</u>
(2) Location: <u>SE 1/4, SW 1/4, Sec 33 T18R6E</u>	<u>Sand</u>	<u>5</u>	<u>24</u>
<u>5</u> miles <u>NE</u> of <u>Warden</u> (distance) (direction) (Nearest Town)	<u>Sand - pipe clay</u>		<u>32</u>
(3) Topography: <u>Hilly</u> (Hilly) (Flat) (Level)	<u>Black Mud</u>	<u>20</u>	<u>52</u>
(4) Purpose of Well: <u>Domestic</u> (Domestic Irrigation Municipal, Industrial, Other)	<u>Sand - clay</u>	<u>9</u>	<u>61</u>
Information upon completion of well:	<u>Gray Sand</u>	<u>17</u>	<u>78</u>
(1) Diameter <u>2</u> inches.	<u>Tan Sand</u>	<u>20</u>	<u>98</u>
(2) Total Depth <u>182</u> feet.	<u>Gray Sand & Mud</u>	<u>10</u>	<u>108</u>
(3) Water Level <u>56</u> feet below top of ground.	CODED	<u>7</u>	<u>115</u>
(4) Cased to <u>172</u> , Size <u>2</u>	<u>Sand</u>	<u>5</u>	<u>120</u>
(5) Screen: Size <u>2</u> , Length <u>10'</u>	<u>Sand - Shale</u>	<u>8</u>	<u>128</u>
(6) Were any formations sealed against pollution? _____ yes, _____ no.	<u>Sand</u>	<u>3</u>	<u>131</u>
If YES depth of formation _____	<u>Shale - Sand</u>	<u>27</u>	<u>158</u>
Why _____	<u>Sand</u>	<u>24</u>	<u>182</u>
Drillers Remarks: _____			

(Use Back Side)

Mail this copy to Board of Water Commissioners 429 Miss. St. Jackson, Miss.