

Carroll
K9
4-67

MISSISSIPPI
BOARD OF WATER COMMISSIONERS
416 North State Street
Jackson, Mississippi 39201

CODED

WATER WELL DRILLERS LOG

4-3 1967 Jack Martin Carroll
date well completed firm name county well located


LANDOWNER:	description of formations encountered	from	to
R E Lee	Clay	0	23
Vaiden	Sand	23	56
Rt.			
(mailing address)			

WELL LOCATION:
sec. 31 T. 18 N R. 5 E
5 miles NW of Vaiden
(distance) (direction) (nearest town)

WELL PURPOSE:
(home, irrigation, municipal, industrial)

- WELL COMPLETION DATA:
- (1) diameter (inches) 2
 - (2) total depth (feet) 56
 - (3) static water level (feet) 36 below top of ground.
 - (4) casing Steel, 51
(material) (depth)
 - 0 If telescope see back.
(size)
 - (5) screen 5, 51
(length) (depth to top)
 - 2, Stainless Steel
(size) (material)
 - (6) pump 3/4, 3
(HP) (yield gpm)
 - Electric
(type power)
 - (7) electric log No
(yes or no)
 - (organization running log)
 - (8) how well bottom plugged 2" Cap

CODED

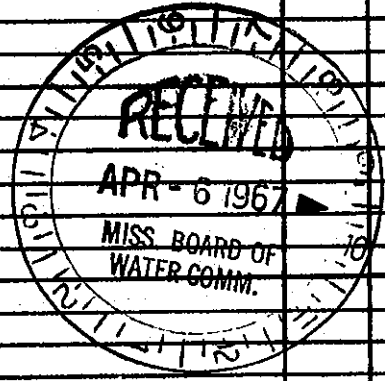

DRILLERS REMARKS: