

CARROLL MISSISSIPPI BOARD OF WATER COMMISSIONERS

L 21

CARROLL
WATER WELL DRILLERS LOG

3-10-63

Date: MAR 10, 1963, Driller: DELTA DRILLING Co. County: MONTGOMERY
(Name)

(1) Owner of Land: <u>ROY RILEY</u> (Name)	Description & Color of Materials Sand, Clay, Red Clay, Shell, etc.	Thick- ness Feet	Depth Feet
(Address)	<u>CLAY</u>	<u>22</u>	<u>22</u>
(2) Location: <u>NE 1/4, SW 1/4, Sec. 28 T10N R7E</u>	<u>SAND</u>	<u>23</u>	<u>45</u>
_____ miles _____ of _____ (distance) (direction) (Nearest Town)	<u>RED CLAY</u>	<u>61</u>	<u>106</u>
(3) Topography: _____ (Hilly) (Flat) (Level)	<u>SAND w/10" ROCK</u>	<u>40</u>	<u>146</u>
(4) Purpose of Well: <u>DOMESTIC</u> (Domestic Irrigation, Municipal, Industrial, Other)	<u>SHALE</u>	<u>34</u>	<u>180</u>
_____	<u>SAND</u>	<u>10</u>	<u>190</u>
_____	<u>REDSAND</u>	<u>21</u>	<u>211</u>
_____	<u>SHALE</u>	<u>21</u>	<u>232</u>

Information upon completion of well:


- (1) Diameter 4 inches.
- (2) Total Depth 190 feet.
- (3) Water Level 87 feet below top of ground.
- (4) Cased to 180, Size 4
- (5) Screen: Size 2, Length 10
- (6) Were any formations sealed against pollution?
_____ yes, _____ no.

If YES, depth of formation _____

Why _____

Drillers Remarks: HOLE DRILLED TO A DEPTH OF 232' AND WELL SET 190'

CODED

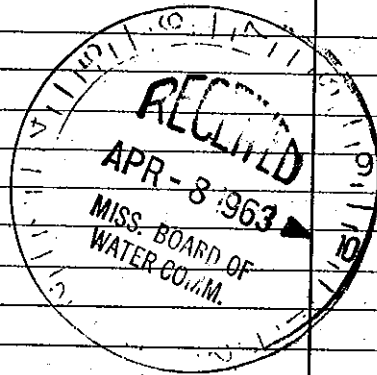

Well No.

(Use Back Side)

Mail this copy to Board of Water Commissioners 429 Miss. St. Jackson, Miss.