

CARROLL

MISSISSIPPI BOARD OF WATER COMMISSIONERS

L 22  
10-63

WATER WELL DRILLERS LOG

Date: Oct, 1963, Driller: Jack Martin County Holmes  
(Name)

(1) Owner of Land:	Description & Color of Materials Sand, Clay, Red Clay, Shell, etc.	Thick- ness Feet	Depth Feet
<u>John Shute</u> (Name)	<u>Clay</u>	<u>24</u>	<u>24</u>
<u>Coila</u> (Address)	<u>Sand</u>	<u>40</u>	<u>64</u>
(2) Location: <u>SE 1/4, SE 1/4, Sec. 1 T17R 2E</u>	<u>Sand - Gravel</u>	<u>88</u>	<u>152</u>
<u>4</u> miles <u>West</u> of <u>Black Hawk</u> (distance) (direction) (Nearest Town)			
(3) Topography: <u>Hilly</u> (Hilly) (Flat) (Level)			
(4) Purpose of Well: <u>Domestic</u> (Domestic Irrigation Municipal, Industrial, Other)			


Information upon completion of well:

- (1) Diameter 2 inches.
- (2) Total Depth 152 feet.
- (3) Water Level 120 feet below top of ground.
- (4) Cased to 147, Size 2
- (5) Screen: Size 2, Length 5
- (6) Were any formations sealed against pollution?  
\_\_\_\_\_ yes, \_\_\_\_\_ no.

If YES depth of formation \_\_\_\_\_

Why \_\_\_\_\_

Drillers Remarks: \_\_\_\_\_

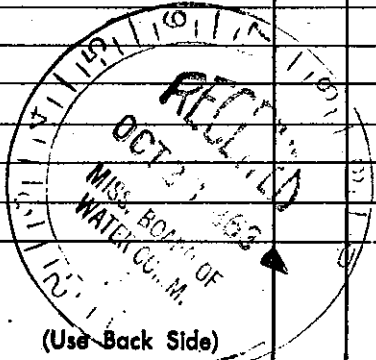

Well No. \_\_\_\_\_

(Use Back Side)

Mail this copy to Board of Water Commissioners 429 Miss. St. Jackson, Miss.