

Carroll  
L 26  
4-67

MISSISSIPPI  
BOARD OF WATER COMMISSIONERS CODED  
416 North State Street  
Jackson, Mississippi 39201

WATER WELL DRILLERS LOG

4-18 1967 Jack Martin Carroll  
date well completed firm name county well located

LANDOWNER: Percy Daves  
Coila  
RA #1  
(mailing address)


WELL LOCATION:  
sec. 3 T. 17 N R. 2 E  
S W  
5 miles NW of Black Hawk  
(distance) (direction) (nearest town)

description of formations encountered	from	to
clay	0	15
sand & gravel	15	35
sand	35	50
sand & gravel	50	85
sand	85	210

WELL PURPOSE: Home  
(home, irrigation, municipal, industrial)

- WELL COMPLETION DATA:
- (1) diameter (inches) 2
  - (2) total depth (feet) 210
  - (3) static water level (feet) 115? below top of ground.
  - (4) casing Steel, 205' (material) (depth)  
2 (size) If telescope see back.
  - (5) screen 5, 205' (length) (depth to top)  
2, Stainless Steel (size) (material)
  - (6) pump 3/4, 3 (HP) (yield gpm)  
Elec (type power)
  - (7) electric log No (yes or no)  
(organization running log)
  - (8) how well bottom plugged Cap

CODED

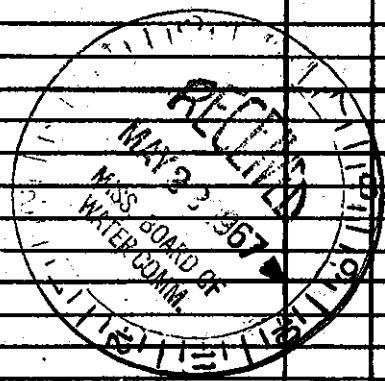

DRILLERS REMARKS: