

Carroll
L 29
68

MISSISSIPPI
BOARD OF WATER COMMISSIONERS
416 North State Street
Jackson, Mississippi 39201

CODED

WATER WELL DRILLERS LOG

Jack Martin's Carroll

date well completed 19 _____ firm name _____ county well located _____

LANDOWNER: G. D. Ellis
Cruzer RT # 1
(mailing address)

description of formations encountered	from	to
Clay	0	36
Sand & Gravel	36	60
Sand - little gravel	60	136
Sand & Mud	136	167
Fine Sand	167	258
Mud	258	290
Sand	290	310


WELL LOCATION:
sec. 21 T. 17 N. R. 2 E
4 1/2 miles W of Black Hawk
(distance) (direction) (nearest town)

WELL PURPOSE:
(home, irrigation, municipal, industrial)

WELL COMPLETION DATA:

- (1) diameter (inches) 2
- (2) total depth (feet) 310
- (3) static water level (feet) 144 ^{below} ~~above~~ top of ground.
- (4) casing Steel, 305',
(material) (depth)
2 If telescope see back.
(size)
- (5) screen 5', 305'
(length) (depth to top)
2, Stainless Steel
(size) (material)
- (6) pump 3/4, 3
(HP) (yield gpm)
Electric
(type power)
- (7) electric log no
(yes or no)
(organization running log)
- (8) how well bottom plugged Cap

CODED

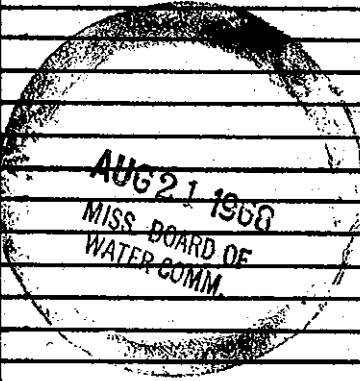

DRILLERS REMARKS: