

Carroll
L 30
9-68

MISSISSIPPI
BOARD OF WATER COMMISSIONERS
416 North State Street
Jackson, Mississippi 39201

WATER WELL DRILLERS LOG

Sept 1968 Jack Martin Carroll
date well completed firm name county well located



LANDOWNER: J. T. Suddeth
Coala Rt 1
(mailing address)

WELL LOCATION:
sec. 12 T. 17 N R. 2 E
3 miles NW of Black Hawk
(distance) (direction) (nearest town)

WELL PURPOSE: Homes
(home, irrigation, municipal, industrial)

- WELL COMPLETION DATA:
- (1) diameter (inches) 2
 - (2) total depth (feet) 130
 - (3) static water level (feet) 61 below top of ground.
 - (4) casing Steel 125' (material) (depth)
2 (size) if telescope see back.
 - (5) screen 5' 125' (length) (depth to top)
2 Stainless Steel (size) (material)
 - (6) pump 3/4 HP 3 (type power) (yield gpm)
 - (7) electric log NO (yes or no)
(organization running log)
 - (8) how well bottom plugged

Description of formations encountered	from	to
clay	0	24
sand & gravel	24	33
Mud	33	62
Gravel & Sand	62	71
pipe clay	71	91
Sand	91	130

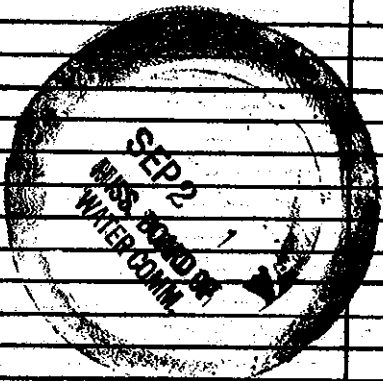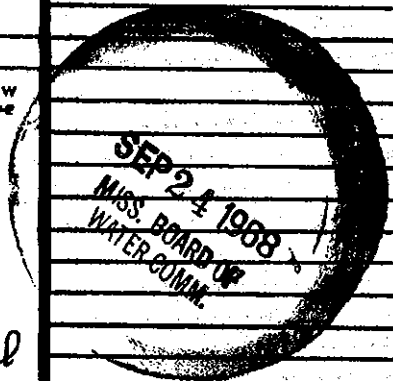

DRILLERS REMARKS: