

WATER WELL DRILLERS LOG

Carroll

L42
5-65

Date: May, 1965, Driller: Jack Martin County Holmes
(Name)

(1) Owner of Land: R. Daves
(Name)
Lexington
(Address)

(2) Location: SW 1/4, SW 1/4, Sec. 22 T17R2E
6 miles SW, of Black Hawk
(distance) (direction) (Nearest Town)

(3) Topography: Hilly
(Hilly) (Flat) (Level)

(4) Purpose of Well: Domestic
(Domestic Irrigation
Municipal, Industrial, Other)

Description & Color of Materials Sand, Clay, Red Clay, Shell, etc.	Thick- ness Feet	Depth Feet
<u>Clay</u>	<u>31</u>	<u>31</u>
<u>Sand little gravel</u>	<u>69</u>	<u>100</u>
<u>Gravel-Sand</u>	<u>32</u>	<u>132</u>
<u>Sand</u>	<u>68</u>	<u>200</u>

Information upon completion of well:

(1) Diameter 2 inches.

(2) Total Depth 199 feet.

(3) Water Level 105' feet below top of ground.

(4) Cased to 194, Size 2


(5) Screen: Size 2, Length 5'

(6) Were any formations sealed against pollution?
_____ yes, _____ no.

If YES depth of formation _____

Why _____

Drillers Remarks: _____

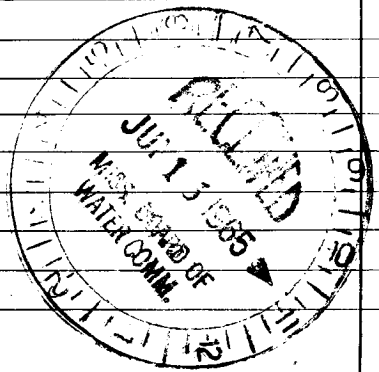

(Use Back Side)

Well No.