

County: Carroll
 Permit #: GW-43966
 Driller: Irrigation Equipment
 Date drilling completed: 5-17-10

State Well Report
Part 1 - Driller's Log
 Mississippi Department of Environmental Quality
 Office of Land and Water Resources
 P.O. Box 2309
 Jackson, MS 39225
 (601)961- 5210
 (601)961- 5228 (fax)

For Office Use Only:
 Aquifer: L44
 Well #: _____
 L. S. Elevation: _____
 E-log #: _____

State Law requires that this report be prepared by the license holder responsible for the work and filed with the Department at the above address within 30 days of completion of drilling of the well or borehole.

Information on Well Owner (Landowner if borehole is not for a water well)	Well or Borehole Location
Owner Name: <u>Johnathan A. Lindsey</u>	Latitude: <u>33° 21' 15.5"</u> Longitude: <u>90° 09' 39.9"</u>
Mailing Address: <u>300 Lakeshore St.</u>	Method of Lat/Long (circle one): Conventional Survey, USGS quad, Hand-held GPS, Survey-grade GPS
<u>Itha Beng Ms. 38941</u> City State Zip Code	<u>SW 1/4 NE 1/4 Sec 11 Twn 17N Rng 1 E</u>
Telephone No. () _____	Distance Direction Nearest Town <u>4</u> Miles <u>SE</u> of <u>Sidon</u>

Well / Borehole Data

Date drilling started: 5-17-10 Date drilling completed: 5-17-10 Hole depth: 121 Hole diameter: 24"

Location of the source of any surface water used for drilling: Surface Water
 Method of dosing and volume of Chlorine used in drilling and development: 50 PPM

Logs run (circle all applicable): No log run Electric Gamma Ray Density Sonic Neutron Other: _____
 Name of organization running log(s): _____

Purpose of borehole (check one): Water Well Geotechnical/Geological Investigation _____ Ground Source Heat Pump _____
 Seismic Survey _____ Other (describe) _____

If drilling is not related to water well construction, skip the remainder of this block

Purpose of Well (check one): Home _____ Industrial _____ Public Supply _____ Irrigation Fish Culture _____ Other: _____

If a flowing well, method of flow regulation: Valve _____ Other (describe) _____

Static Water Level: 11 feet above or below (circle one) land surface Date measured: 5-25-10

Method of Measurement (circle one) steel tape electric tape air line other: _____

Well depth: 121 Well grouted to a depth of 10 feet Type of grout (circle one): Neat Cement Bentonite Mix


Casing length: 81 feet Casing diameter: 16 inches Type of casing: PVC


Screen length: 40 feet Screen diameter: 16 inches Type of screen: PVC


Screen slot size: .050 inches Setting depth: From 82 feet to 121 feet

Type of completion (circle all applicable): Gravel packed Underreamed Telescoped Open hole Natural Development
 Other (describe): _____


Top of lap pipe or reduction in casing: _____ feet. *If telescoped or more than one screen, describe on next page*

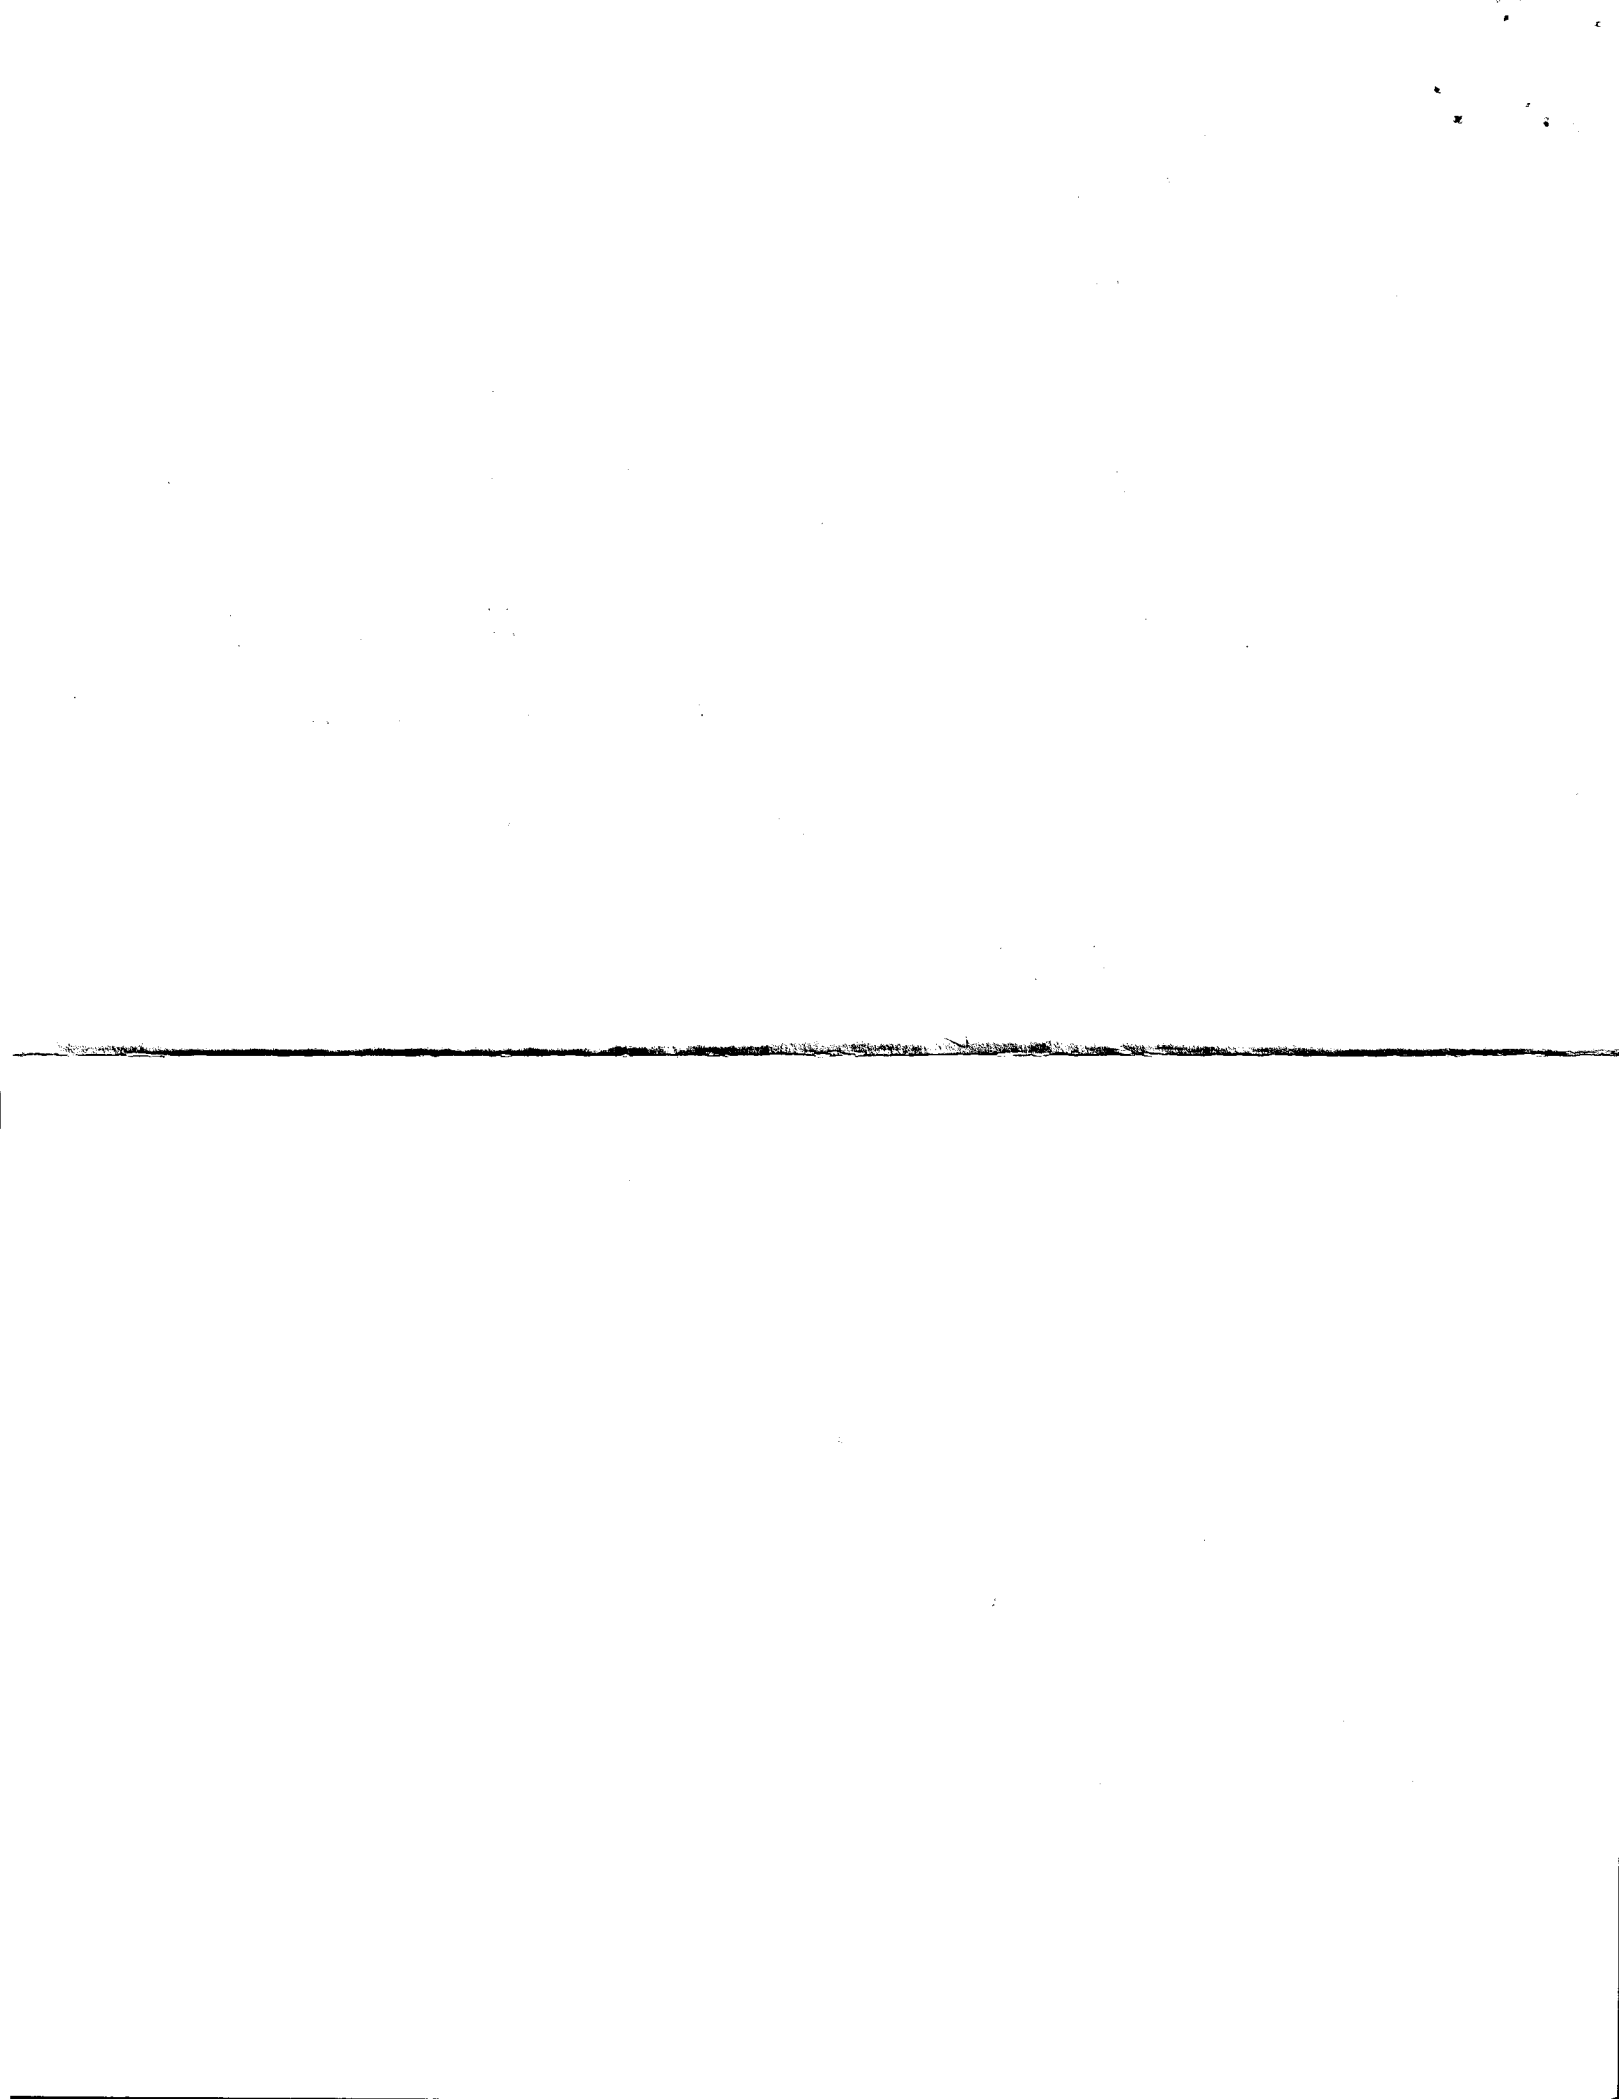

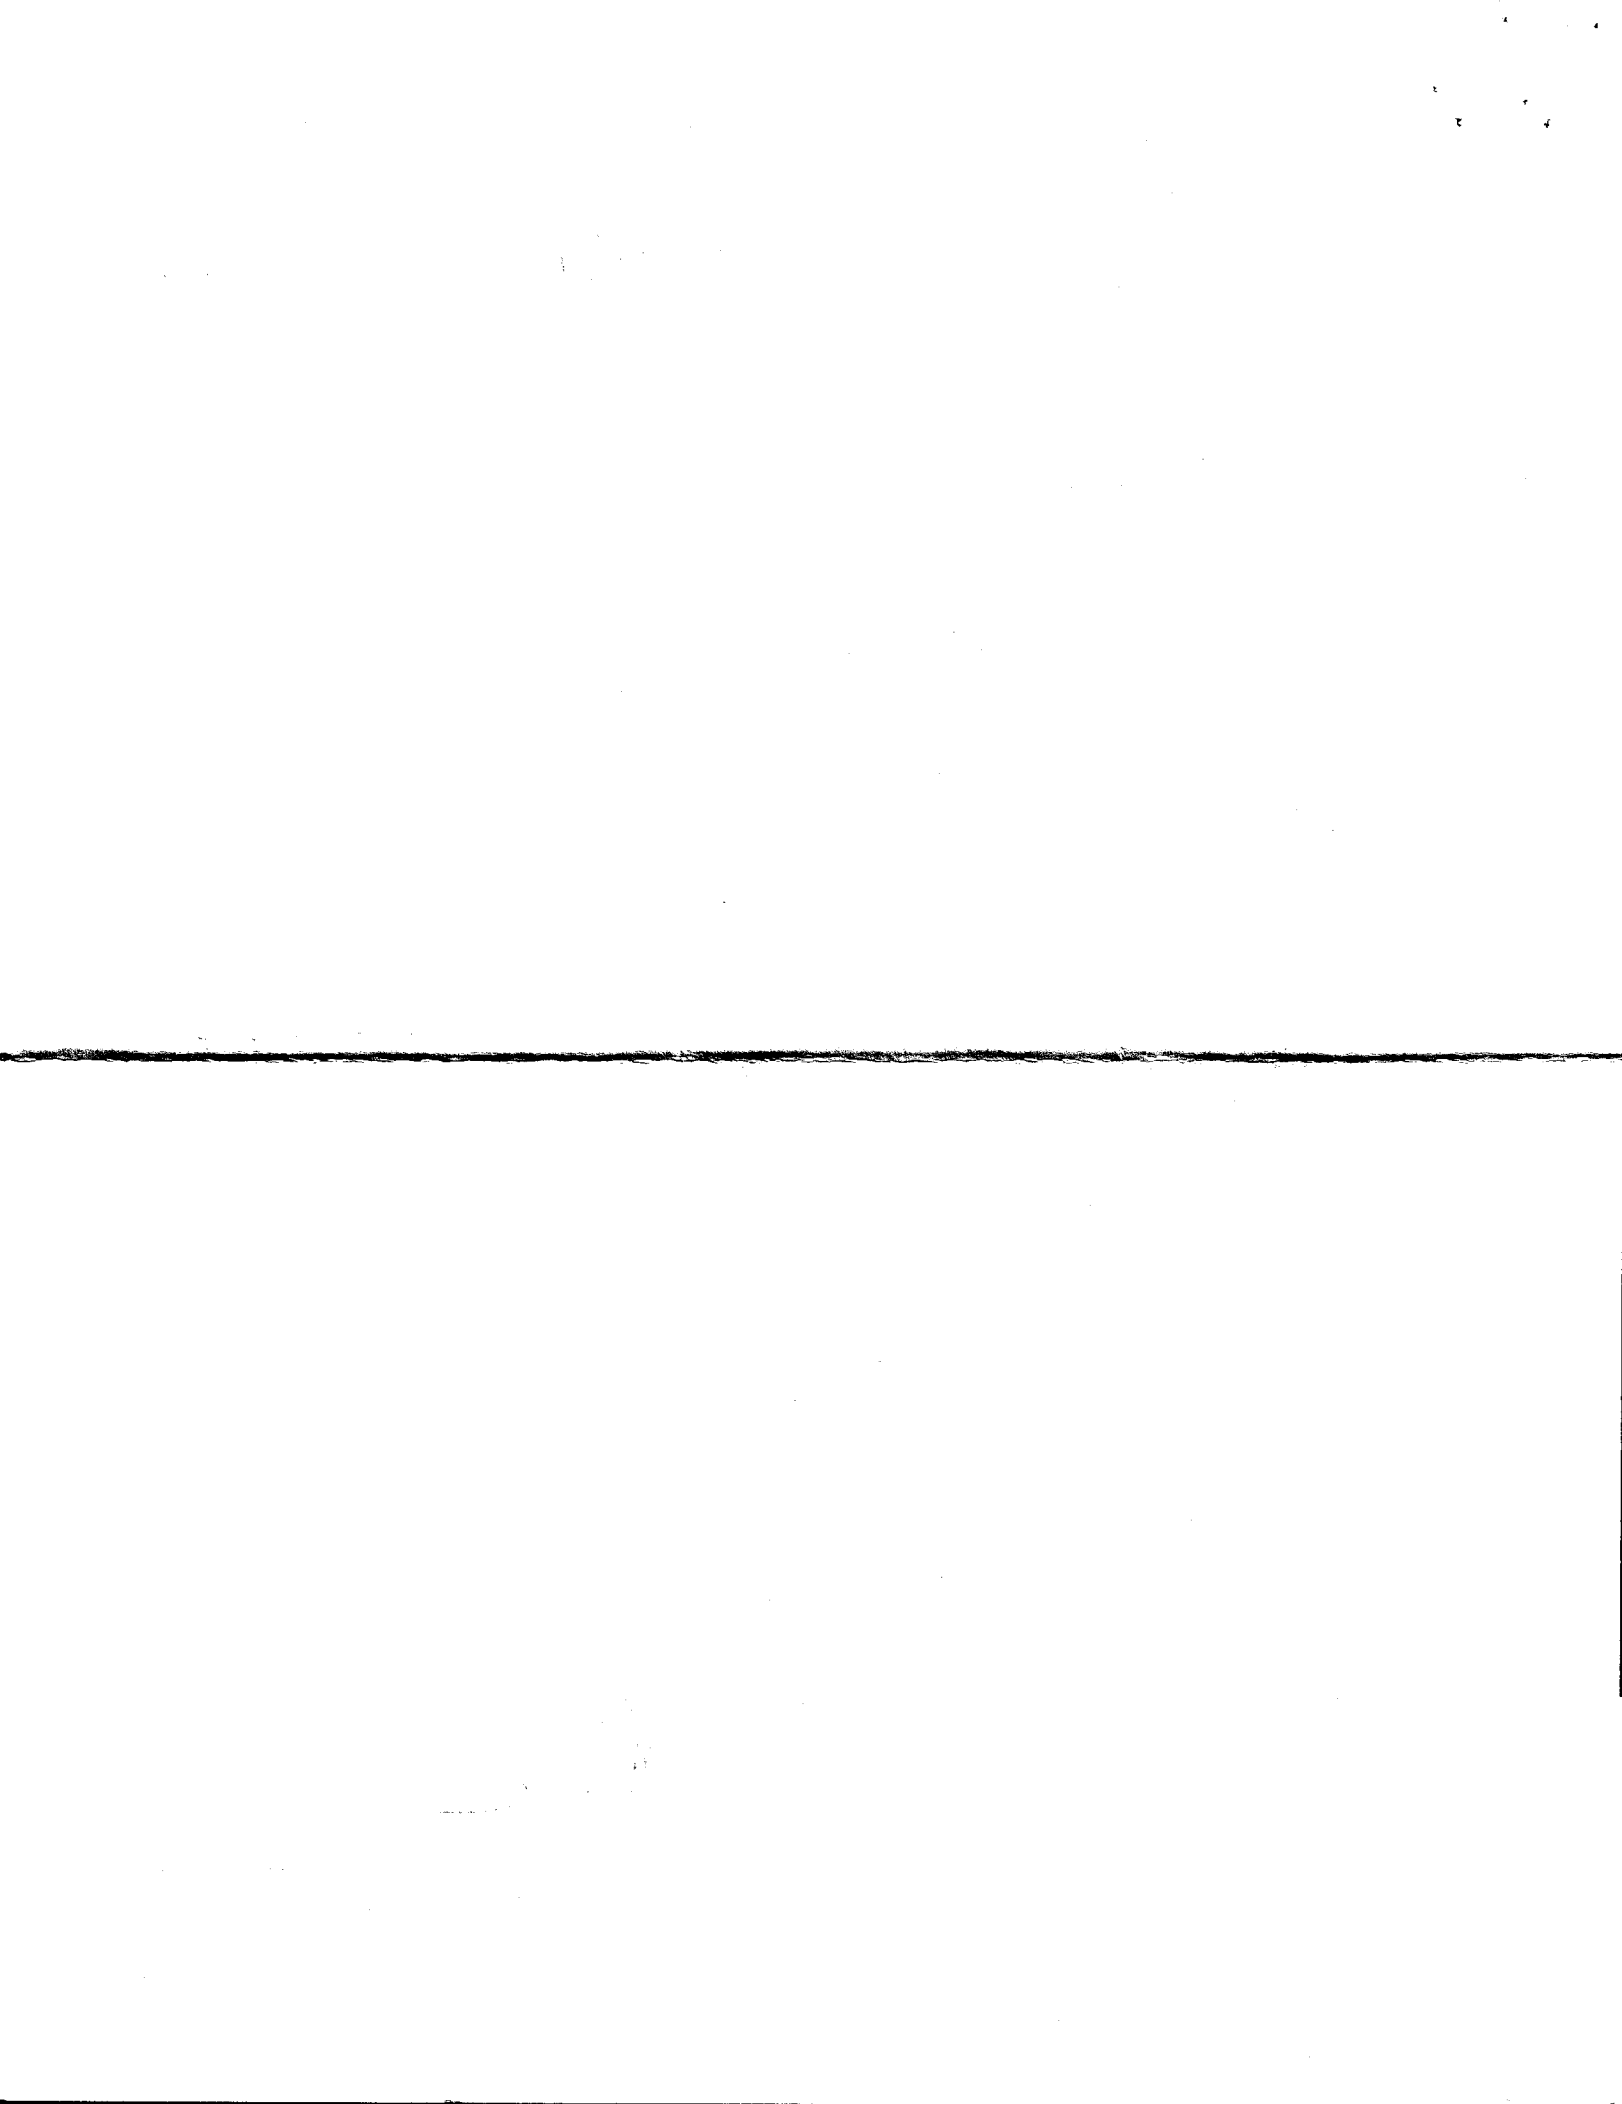

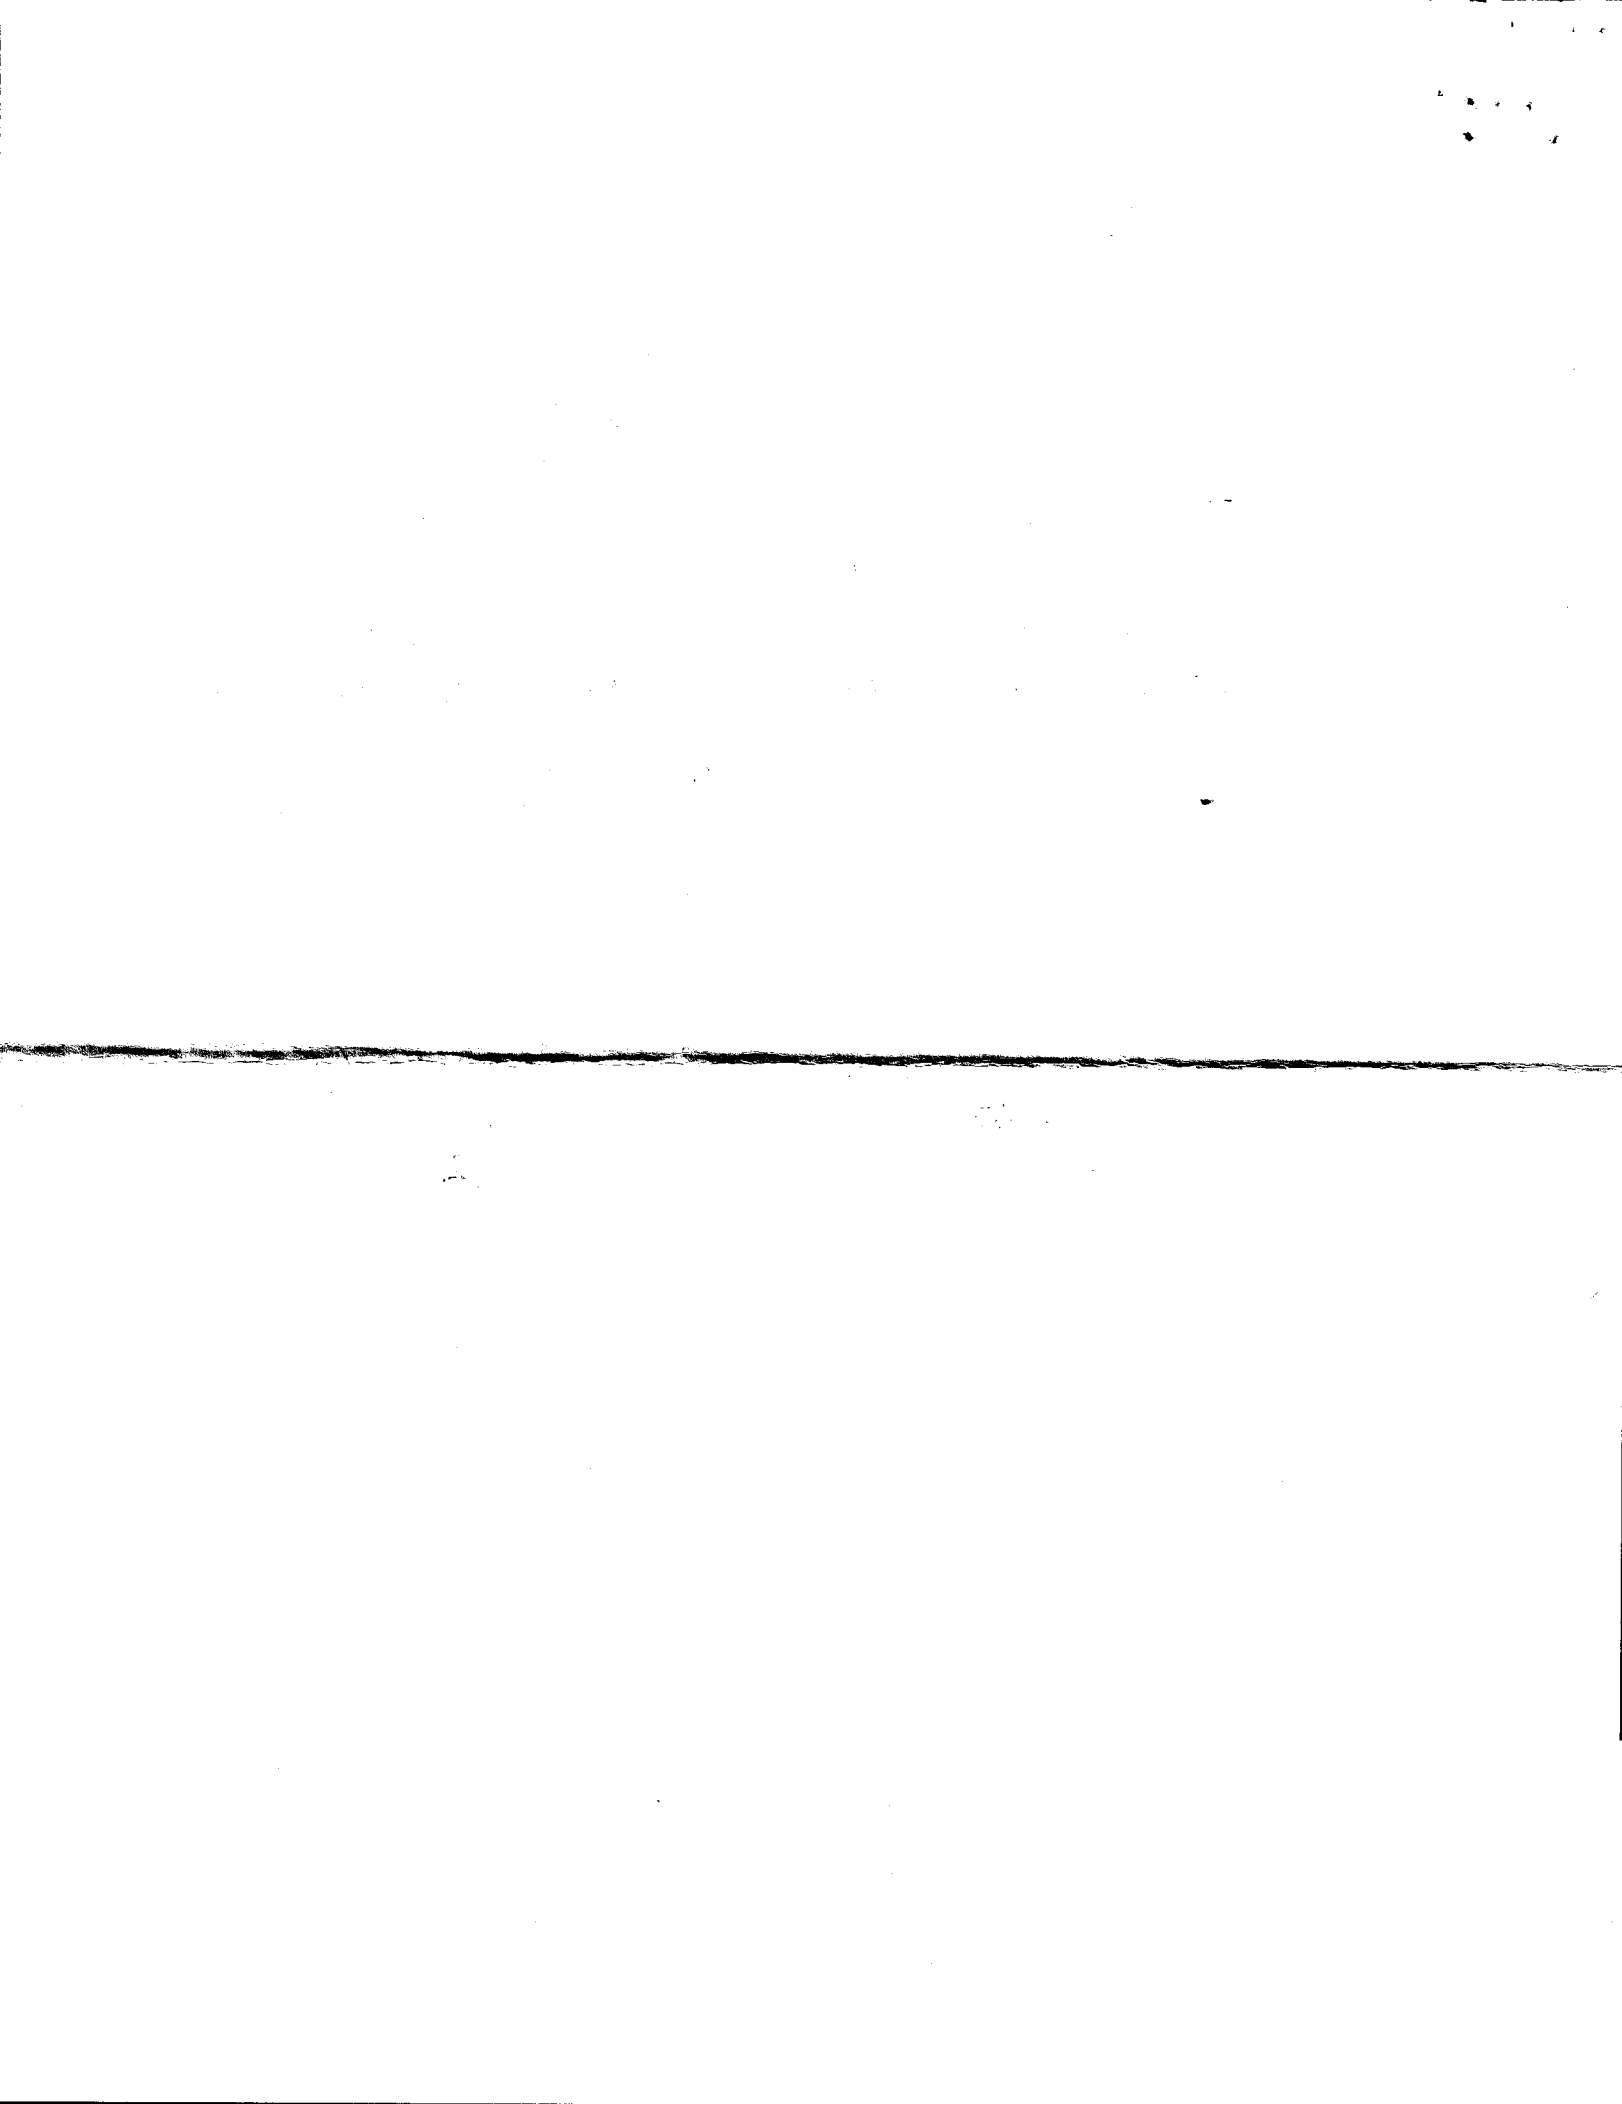

244

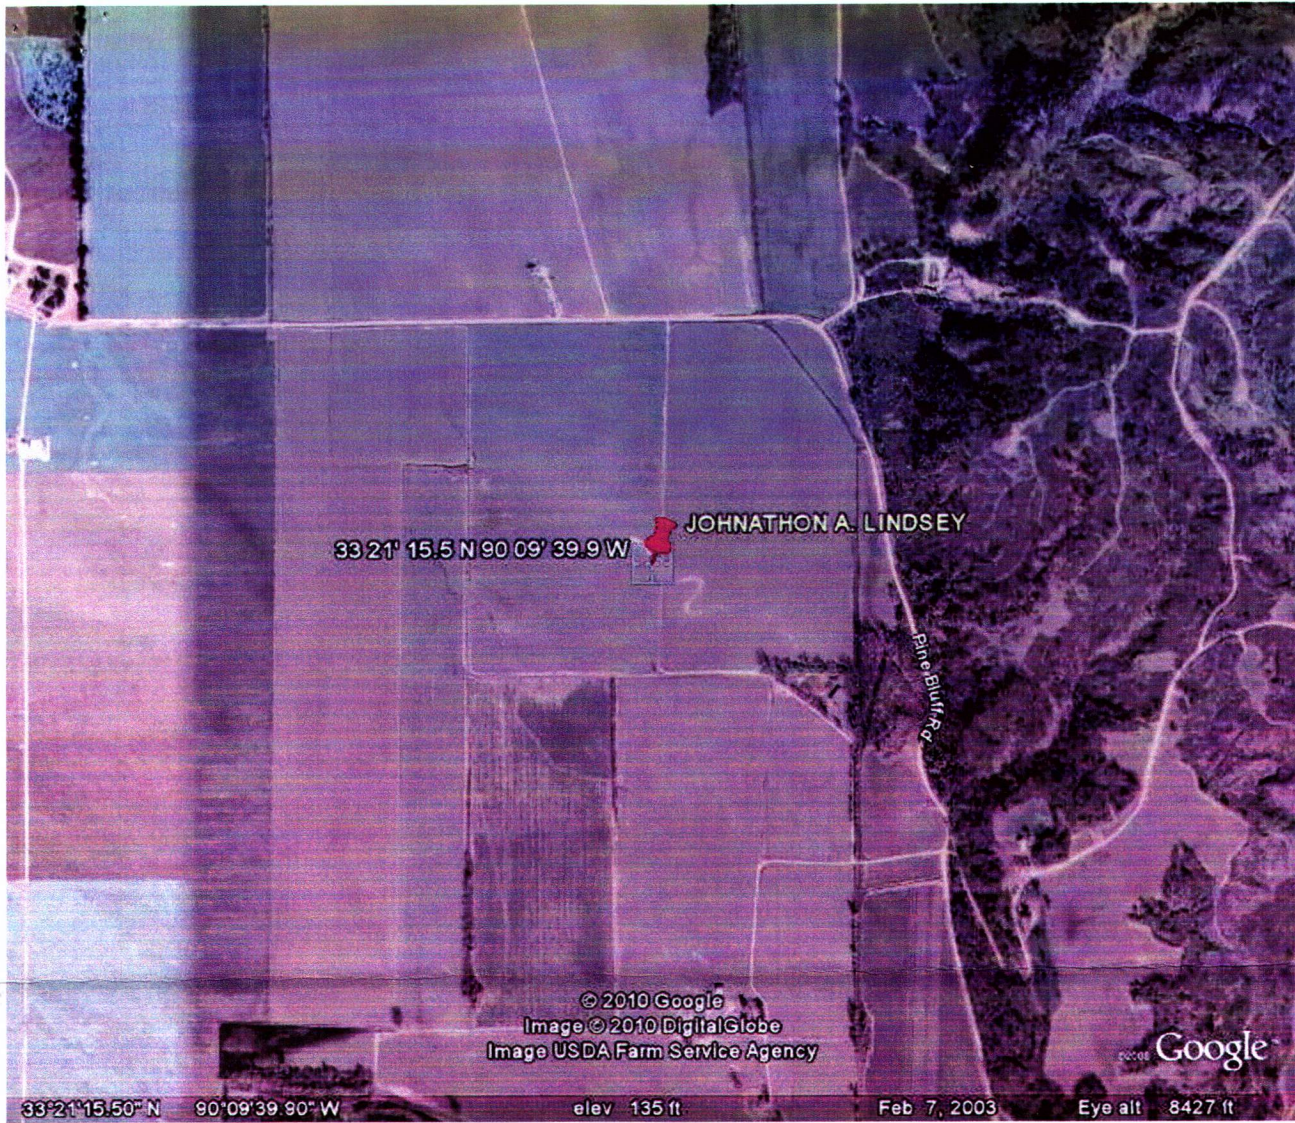

RECEIVED
JUN 01 2010
BY: OLWR